IREDELL COUNTY HEALTH DEPARTMENT

Statesville Office (704) 878-5305 Mooresville Office (704) 660-3625 PERMIT # 175951

IMPROVEMENT PERMIT / AUTHORIZATION TO CONSTRUCT / OPERATION PERMIT / EXISTING SYSTEM

PIN # 4746364549

APPLICANT: NCA of the Carolinas Inc APPLICANT ADDRESS: PO Box 690115

SITE ADDRESS: 249 Shumaker Dr. Statesville PHONE: 704-545-1114 ALT. PHONE: 704-426-9810

SITE DIRECTIONS: Hwy 21 N TL Shumaker Rd.

SUBDIVISION: N/A SECTION: N/A LOT # N/A LOT AREA: 0.515 acres DESIGN FLOW: 360gpd L.T.A.R.: Existing

Septic Tank 1000 (gal) STB 1L0 Date 10-19-12
Pump Tank (gal) PT Date
Pump Make Model Serial #
Nitrification Fields 2 # Lines 6x Linear Ft: 6x
Trench Width Existing Max. Trench Bottom Depth Existing Gravel Depth Existing


☐ New System ☐ Repair ☐ Expansion System Type: I (II) III IV V VI
System Description:
Repair System Description: Conventional
Maintenance Agreement Required: ☐ YES ☑ NO
☑ GRAVITY ☐ PRESSURE

☑ Residence No. Bedrooms 3
☐ Business No. Persons
☐ Other No. Employees
☑ Slab ☐ Crawl Space
☐ Basement w/plumbing ☐ Basement w/o plumbing

Water Supply
☐ Private
☑ Public
☐ Community

Comments / Conditions: Set new septic tank as shown in drawing, Use a bull run valve to connect the two existing beds to the septic tank as shown.

INITIAL SITE SKETCH

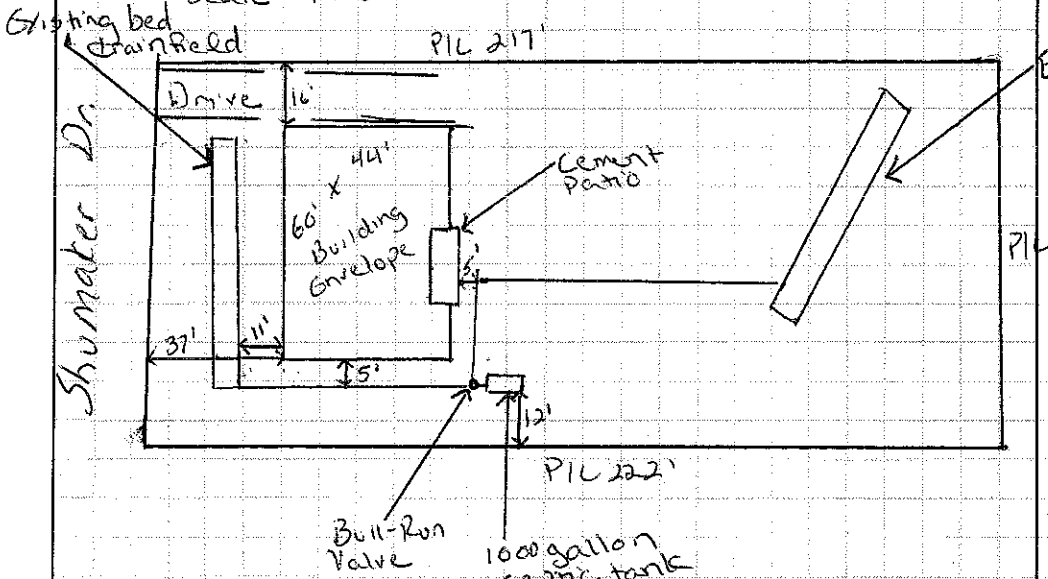

AS BUILT SKETCH

- Red Polylok filter installed
- 2" PVC septic tank marker installed
- Installed as drawn

Permit can be suspended or revoked if any false information is supplied toward securing the permit / any unauthorized changes are made to the site / any unauthorized changes are made in the installation of the system. **CONTACT A LOCATOR SERVICE PRIOR TO ANY EXCAVATION**

☐ **IMPROVEMENT PERMIT** *with plat valid without expiration.* ☑ **IMPROVEMENT PERMIT** *with site plan valid for 60 mos.* ☑ **AUTHORIZATION TO CONSTRUCT** *valid for period equal to IMPROVEMENT PERMIT--not to exceed 60 mo.*

Owner / Applicant Signature: [signature] Date: 12/31/12 Installed by: Dennis Hoyle Services

IMPROVEMENT PERMIT by: Justin Henderson Date: 12-21-12 OPERATION PERMIT by: Justin Henderson Date: 3-11-13

AUTHORIZATION TO CONSTRUCT by: Justin Henderson Date: 12-21-12 Existing System Inspected by: Date:

Health Dept. Copy - WHITE Applicant (Final Approval) - YELLOW Applicant (Conditional Approval) - PINK