IREDELL COUNTY HEALTH DEPARTMENT

Statesville Phone TR 3-7271 Mooresville Phone NO 3-1271

PERMIT TO INSTALL SEPTIC TANK

Permit No. 356 Permit Date May 20 1971

Owner Hope Bros. Builders Address Statesville, NC

Installed By Lackey Bros Address Stony Point, NC

Location of Property


IREDELL HEIGHTS - LOT 576

Tank		Capacity		Length of Lines		Fixtures	
Block	( )	1000	(✓)	225'	( )	No. of Baths	( )
Precast	(✓)	1250	( )	250'	( )	Dishwasher	( )
		1500	( )	Other 300		Garbage Grdr.	( )
		Other		900 5		Other	

NOTIFY HEALTH DEPARTMENT AT LEAST EIGHT HOURS BEFORE TANK IS TO BE INSPECTED.

Final Inspection May 20 1971 Approved (✓) Disapproved ( )

Remarks IREDELL WATER Corp.

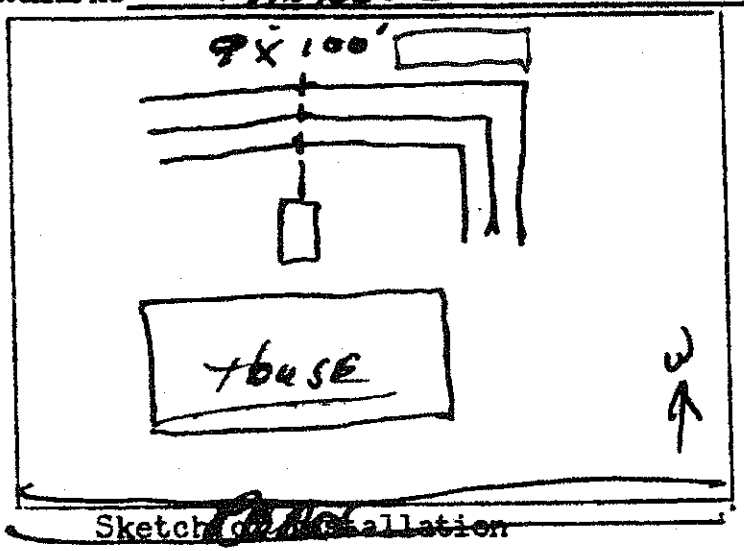

Sketch of Installation

Location of the proposed Accessory Building addition does not appear to impact the existing on-site septic system.**NOTE: KEEP MIN 5' FROM SYSTEM

R. STEVE HEDRICK REHS

Date: MARCH 14, 2013

ICHD-Environmental Health Division

Sanitarian