IRE... COUNTY HE... DEPARTMENT

...ville Phone TR 3-7271 Mooresville Phone No. 664

PERMIT TO INSTALL SEPTIC TANK

...o. 69 Permit Date 11-13 19 71

...Bill Anderson Address Statesville NC

...led By Ray Lentz Address Statesville NC

...cation of Property Iredell Heights - Lot #39


Corner of Nixon Rd & Polly Dr. on R.

Tank		Capacity		Length of Lines		Fixtures	
Block	( )	1000	(✓)	225'	(✓)	No. of Baths	(1½)
Precast	(✓)	1250	( )	250'	( )	Dishwasher	( )
		1500	( )	Other		Garbage Grdr.	( )
		Other				Other	

NOTIFY HEALTH DEPARTMENT AT LEAST EIGHT HOURS BEFORE TANK IS TO BE INSPECTED.

Final Inspection 11-13 19 71 Approved (✓) Disapproved ( )

Remarks Community Water

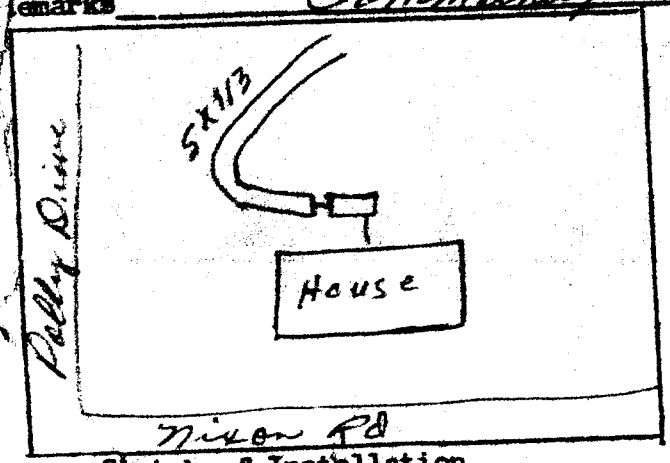

Sketch of Installation

E. G. Stevenson

Sanitarian