IREDELL COUNTY HEALTH DEPARTMENT

Statesville Office (704) 878-5305 Mooresville Office (704) 660-3625 PERMIT # 218146

IMPROVEMENT PERMIT / AUTHORIZATION TO CONSTRUCT / OPERATION PERMIT / EXISTING SYSTEM

PIN # 4746370216

APPLICANT: Lawrence E. Sipe APPLICANT ADDRESS: 607 Georgia Ave

SITE ADDRESS: 114 Polly Dr Statesville NC PHONE: 704-876-6706 ALT. PHONE: 704-872-7667


SITE DIRECTIONS: 21 N to White Farm Rd T/L Nixon Rd T/R Polly Dr Lot on right corner of Grayln

SUBDIVISION: Bobby Cline Add to Iredell Heights SECTION: N/A LOT # 40 LOT AREA: 0.42 ac DESIGN FLOW: 360 L.T.A.R.: Ex

Septic Tank	1000	(gal)	STB	740	Date	3-8-16	☐ New System	☒ Repair	☐ Expansion	System Type: I / II / III IV V VI	☒ Residence	No. Bedrooms	3	Water Supply			
Pump Tank	N/A	(gal)	PT	N/A	Date	N/A	System Description:			Tank	☐ Business	No. Persons	6	☐ Private			
Pump Make	N/A		Model	Polylok	Serial #	PZ-68	Repair System Description:				☐ Other	No. Employees		☒ Public			
# Nitrification Fields	Ex		# Lines	Ex	Linear Ft:	Ex	Maintenance Agreement Required:	☐ YES	☒ NO		☐ Slab	☒ Crawl Space		☐ Community			
Trench Width	Ex		Max. Trench Bottom Depth	Ex	Gravel Depth	Ex		☒ GRAVITY	☐ PRESSURE		☐ Basement w/plumbing			☐ Basement w/o plumbing			

Comments / Conditions: Pump, crush + fill existing tank. Maintain 10' off Back P/L with Septic tank and 5' off house

INITIAL SITE SKETCH

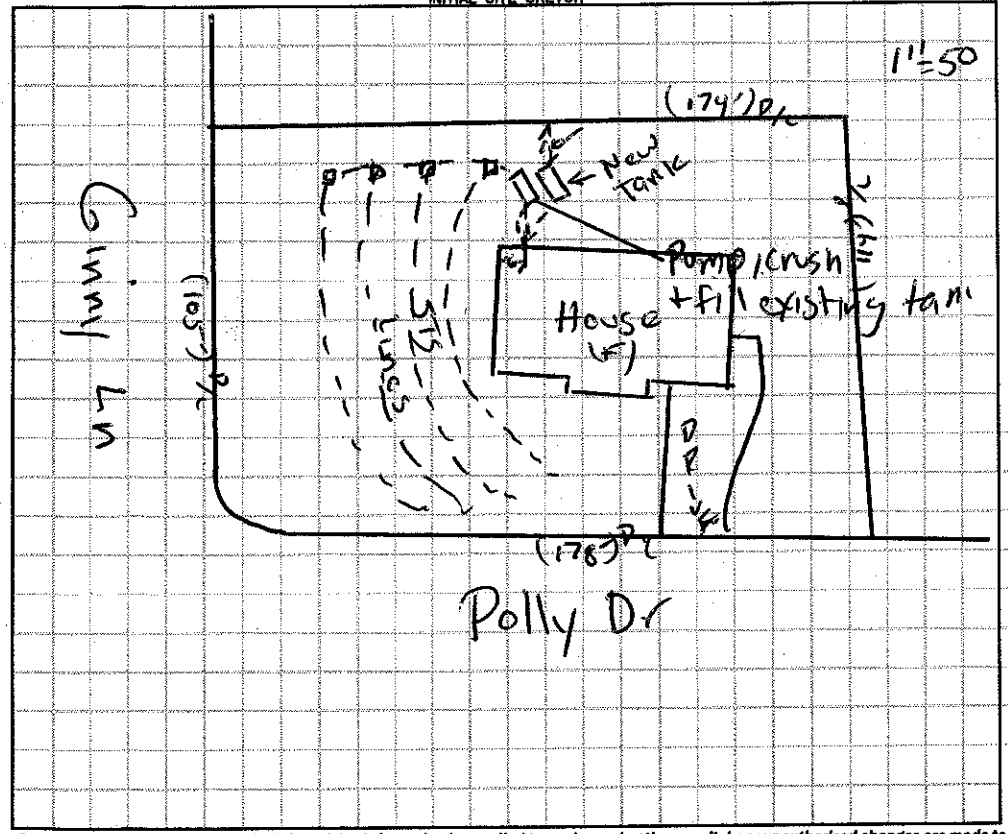

AS BUILT SKETCH

Installed as drawn

Pumped, crushed + filled existing tank

Permit can be suspended or revoked if any false information is supplied toward securing the permit / any unauthorized changes are made to the site / any unauthorized changes are made in the installation of the system. **CONTACT A LOCATOR SERVICE PRIOR TO ANY EXCAVATION**

☐ **IMPROVEMENT PERMIT** *with plat valid without expiration.* ☒ **IMPROVEMENT PERMIT** *with site plan valid for 60 mos.* ☒ **AUTHORIZATION TO CONSTRUCT** *valid for period equal to IMPROVEMENT PERMIT--not to exceed 60 mo.*

Owner / Applicant Signature: Date: 5/2/16 Installed by: A-1 Backhoe

IMPROVEMENT PERMIT by: Date: 04/25/16 OPERATION PERMIT by: Date: 06/07/16

AUTHORIZATION TO CONSTRUCT by: Date: 04/25/16 Existing System Inspected by: Date:

Health Dept. Copy - WHITE Applicant (Final Approval) - YELLOW Applicant (Conditional Approval) - PINK