IREDELL COUNTY HEALTH DEPARTMENT

Statesville Phone TR 3-7271 Mooresville Phone No. 664-5281

PERMIT TO INSTALL SEPTIC TANK

Permit No. 14 Permit Date 10-20 1972

Owner GILBERT LACKEY Address STATESVILLE, NC

Installed By LARKEY BROS. Address STONY POINT, NC


Location of Property IREDELL HEIGHTS - NEW DEVELOPMENT - POLLY DR. LOT #32

Tank		Capacity		Length of Lines		Fixtures	
Block	( )	1000	( )	225'	( )	No. of Baths	(1½)
Precast	(✓)	1250	( )	250'	( )	Dishwasher	(1)
		1500	( )	Other 2x0		Garbage Grdr.	( )
		Other				Other	

NOTIFY HEALTH DEPARTMENT AT LEAST EIGHT HOURS BEFORE TANK IS TO BE INSPECTED.

Final Inspection 10-20 1972 Approved (✓) Disapprcved ( )

Remarks IREDELL WATER CO.

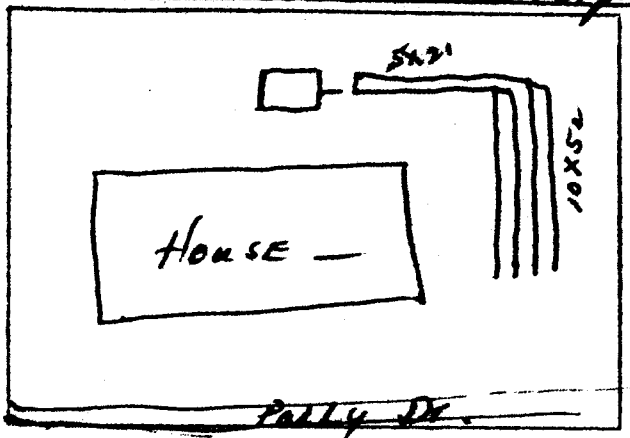

Sketch of Installation

Sanitarian