IREDELL COUNTY HEALTH DEPARTMENT

Statesville Phone TR 3-7271 Mooresville Phone No. 664-5281

PERMIT TO INSTALL SEPTIC TANK

Permit No. 110 Permit Date 2-5 1923

Owner WILLIAM HIGGANS - Address STATESVILLE, NC.

Installed By TAYLORSVILLE GRADING CO. Address TAYLORSVILLE, NC.

Location of Property IREDELL HEIGHTS


GINNY LANE - LOT # 41

Tank		Capacity		Length of Lines		Fixtures	
Block	( )	1000	(✓)	225'	( )	No. of Baths	(1½)
Precast	(✓)	1250	( )	250'	( )	Dishwasher	( )
		1500	( )	Other 245		Garbage Grdr.	( )
		Other				Other	

NOTIFY HEALTH DEPARTMENT AT LEAST EIGHT HOURS BEFORE TANK IS TO BE INSPECTED.

Final Inspection 2-5 1923 Approved (✓) Disapprcved ( )

Remarks IREDELL WATER CORP.

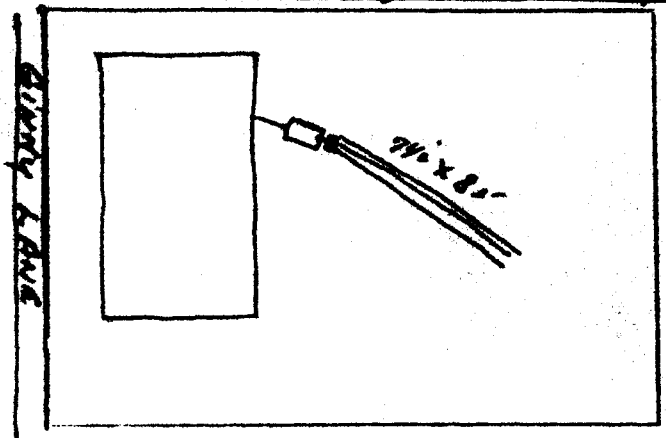

Sketch of Installation

Sanitarian