IREDELL COUNTY HEALTH DEPARTMENT

Statesville Phone TR 3-7271 Mooresville Phone No. 664-5281

PERMIT TO INSTALL SEPTIC TANK

Permit No. 124 Permit Date 12-28 1972

Owner Southerland Bldg Co. Address Statesville, NC

Installed By Taylorsville Grading Co Address Taylorsville, NC.

Location of Property IREDELL HEIGHTS

Shoemaker Rd


Lot #22

Tank		Capacity		Length of Lines		Fixtures	
Block	( )	1000	(✓)	225'	(✓)	No. of Baths	(1½)
Precast	(✓)	1250	( )	250'	( )	Dishwasher	( )
		1500	( )	Other 240		Garbage Grdr.	( )
		Other				Other	

NOTIFY HEALTH DEPARTMENT AT LEAST EIGHT HOURS BEFORE TANK IS TO BE INSPECTED.

Final Inspection 12-28 1972 Approved (✓) Disapprcved ( )

Remarks IREDELL WATER CORP.

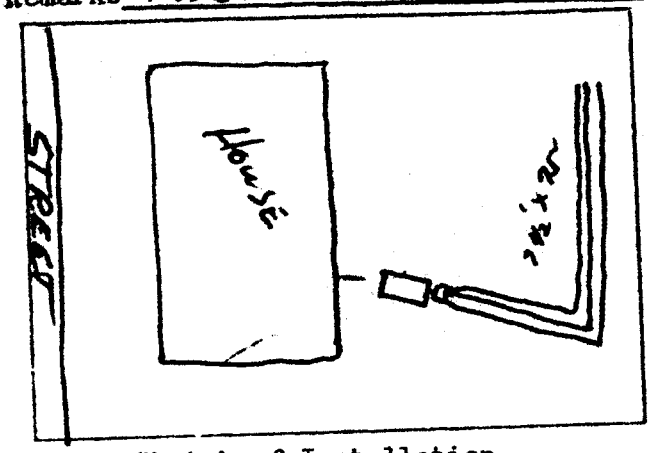

Sketch of Installation

Sanitarian