IREDELL COUNTY HEALTH DEPARTMENT

Statesville Phone TR 3-7271 Mooresville Phone No. 664-5281

PERMIT TO INSTALL SEPTIC TANK

Permit No. 112 Permit Date 12-19 1971

Owner Southland Const Co (B&S) Address Statesville N.C.

Installed By Taylorsville Grading Co Address Taylorsville NC.

Location of Property Iredell Hts Lot #22


N-Corner Shumaker Dr & Ginny Lane

Tank		Capacity		Length of Lines		Fixtures	
Block	( )	1000	(✓)	225'	(✓)	No. of Baths	(1½)
Precast	(✓)	1250	( )	250'	( )	Dishwasher	( )
		1500	( )	Other		Garbage Grdr.	( )
		Other				Other	

NOTIFY HEALTH DEPARTMENT AT LEAST EIGHT HOURS BEFORE TANK IS TO BE INSPECTED.

Final Inspection 12-19 1971 Approved (✓) Disapproved ( )

Remarks Iredell Water Corp

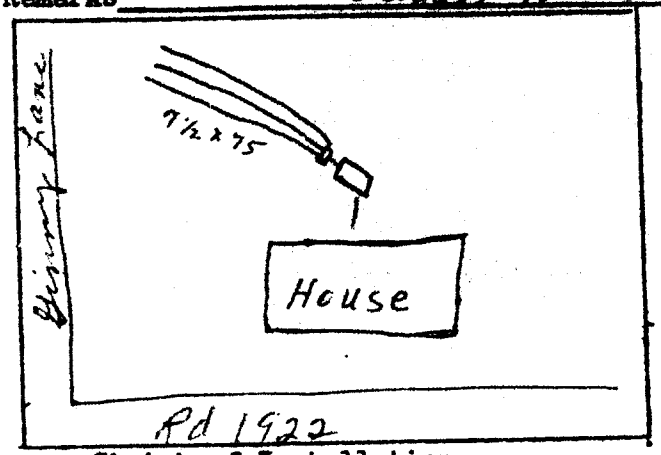

Sketch of Installation

Tank is 3 feet + in ground

E. G. Stevenson

Sanitarian