IREDELL COUNTY HEALTH DEPARTMENT

STATESVILLE 704-878-5305 MOORESVILLE 704-664-5281

IMPROVEMENT PERMIT / AUTHORIZATION TO CONSTRUCT / OPERATION PERMIT / EXISTING SYSTEM INSPECTION

PERMIT # Repair PIN # 4746-38-0163 DATE 19 October 09

OWNER or APPLICANT Brandon Tarlton PHONE: Business (704) 657-5593 Home:

OWNER or APPLICANT ADDRESS 155 Polly Drive Statesville N.C.

LOCATION / DIRECTIONS Hwy 21 N Th Shumaker Dr. Th Polly Dr. Lot on Rt before curve.

SUBDIVISION Iredell Heights BLOCK / SECTION LOT # 13 LOT AREA DESIGN FLOW 360 gpd. L.T.A.R. exist.

Septic Tank 1000 Gallons: STB 760 Date 9-10-09

Pump Tank Gallons: P T Date

Pump Make Model Serial #

Nitrification Field No Fields No Lines Linear Feet

Trench Width Max. Trench Bottom Depth Gravel Depth

☐ New System ☑ Repair ☐ Expansion System Type I II III IV V VI

System Description: Septic tank replacement

Repair System Description:

Maintenance Agreement Required ☐ YES ☒ NO

☑ GRAVITY ☐ PRESSURE

☑ Residence No. Bedrooms 3

☐ Business No. Persons

☐ Other No. Employees

☐ Slab ☑ Crawl Space


☐ Basement w/plumbing ☐ Basement w/o plumbing

Water Supply: ☐ Private ☒ Public ☐ Community

Comments / Conditions: Excavate old tank and replace with New 1000 gl. ST.


INITIAL SITE SKETCH

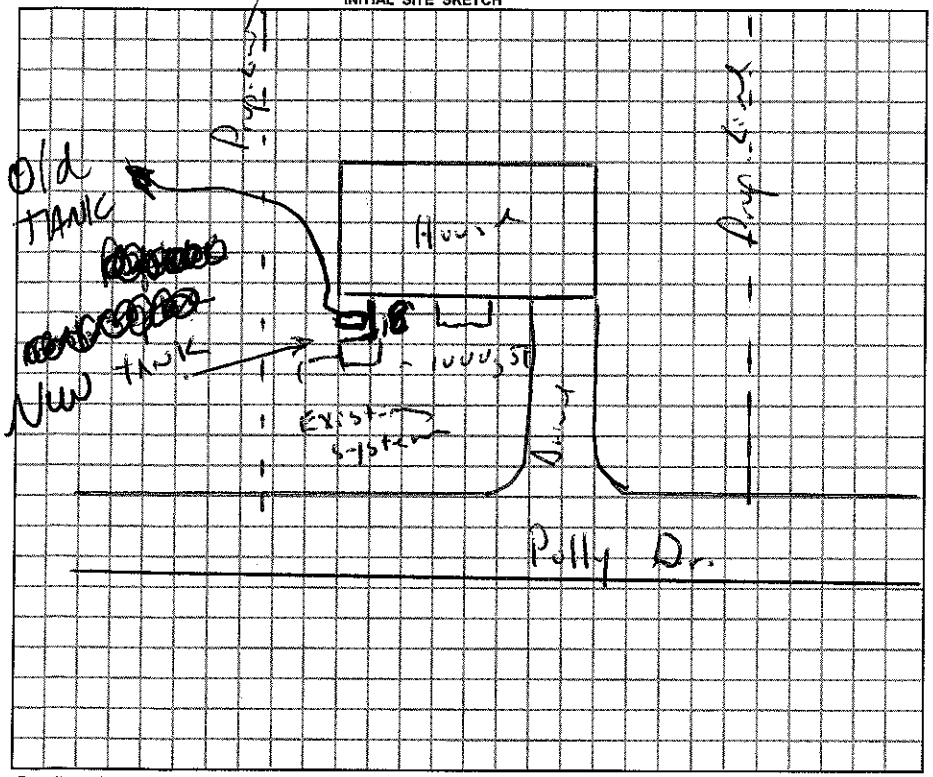

AS BUILT SKETCH

Permit can be suspended or revoked if any false information is supplied toward securing the permit / any unauthorized changes are made to the site / any unauthorized changes are made in the installation of the system.

☐ *IMPROVEMENT PERMIT w / plat valid without expiration.* ☑ *IMPROVEMENT PERMIT w / site plan valid for 60 mos.* ☑ *AUTHORIZATION TO CONSTRUCT valid for period equal to IMPROVEMENT PERMIT-not to exceed 60 mo.*

Owner / Applicant Signature: Brandon Tarlton Date 10/22/09

Improvement Permit by: Date

Authorization to Construct by: R.S. Date 19 Oct. 09

Installed by: David Lentz

Operation Permit by: Date: 10-22-09

Existing System Inspected by: Date:

YOU SHOULD CONTACT A LOCATOR SERVICE PRIOR TO ANY EXCAVATION.

WHITE COPY Environmental Health YELLOW COPY (Final) Owner / Applicant PINK COPY (Initial) Owner / Applicant