IRED[illegible] [illegible]TMENT

[illegible]esville Phone TR 3-7271 Mooresville Phone No. 664-5281

PERMIT TO INSTALL SEPTIC TANK

Permit No._____ Permit Date_____ 19__

Owner Bill Anderson Address_____

Installed By Dan & Jim Lackey Address_____


Location of Property Iredell Heights - New Section (#13?)

Tank		Capacity		Length of Lines		Fixtures	
Block	( )	1000	(✓)	225'	( )	No. of Baths	(1½)
Precast	(✓)	1250	( )	250'	( )	Dishwasher	(/)
		1500	( )	Other 240		Garbage Grdr.	( )
		Other _____				Other _____	

NOTIFY HEALTH DEPARTMENT AT LEAST EIGHT HOURS BEFORE TANK IS TO BE INSPECTED.

Final Inspection 9-25-1973 Approved (✓) Disapproved ( )

Remarks_____

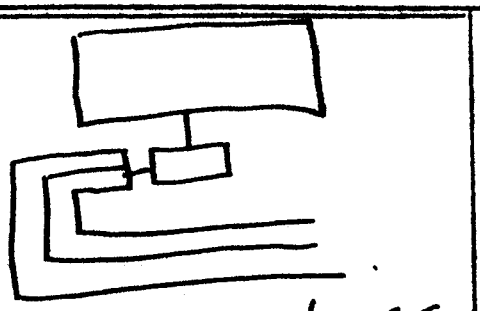

Sketch of Installation

C. S. Lee

Sanitarian