IREDELL COUNTY HEALTH DEPARTMENT

STATESVILLE 704-878-5305 MOORESVILLE 704-664-5281

IMPROVEMENT PERMIT / AUTHORIZATION TO CONSTRUCT / OPERATION PERMIT / EXISTING SYSTEM INSPECTION

PERMIT# REPAIR PIN# 4746-38-5142 DATE 10-13-06

OWNER OR APPLICANT KENNETH D. HARRIS PHONE: Business 704-876-2808 Home 704-876-0795

ADDRESS 323 SHUMAKER DRIVE, STATESVILLE, NC 28625-8920

LOCATION US 21 NORTH TL SHUMAKER DRIVE 1ST HOUSE ON LEFT PAST POLLY ROAD AT #323

SUBDIVISION IREDELL HEIGHTS BLOCK / SECTION ____ LOT 19 LOT AREA AMPLE SITE CLASS. PS DESIGN FLOW 480 L.T.A.R. 0.30 GPD/FT2

Septic Tank: EXISTING Gallons: STB ____ Date ____

Pump Tank: ____ Gallons: PT ____ Date ____

Pump Make: ____ Model ____ Serial No. ____

Nitrification Field: No Fields 1 Square Feet 60 TO 400 Linear Feet 100

No Lines ONE Trench Width 36" Max Trench Bottom Depth 36"

☐ New System ☑ Repair ☐ Expansion System Type: ☐ I ☐ II ☐ III ☐ IV ☐ V ☐ VI

System Description: ____

Repair System Description: 25% REDUCTION

Maintenance Agreement Required: ☐ Yes ☑ No

Gravel Depth N/A ☑ Gravity ☐ Pressure

☑ House/Mod. Home No. Bedrooms 4

☐ Mobile Home No. Persons ____

☐ Business No. Employees ____

☐ Other ____


☐ Slab ☑ Crawl Space ☐ Basement w/plumbing ☐ Basement wo/plumbing

Water Supply: ☐ Individual ☑ Public ☐ Community


Comments:/Conditions: EXTEND EXISTING BED (9'x80') WITH NEW 3'x100' 25% REDUCTION SYSTEM AS FLAGGED.

Comments:/Conditions:

INITIAL SITE SKETCH

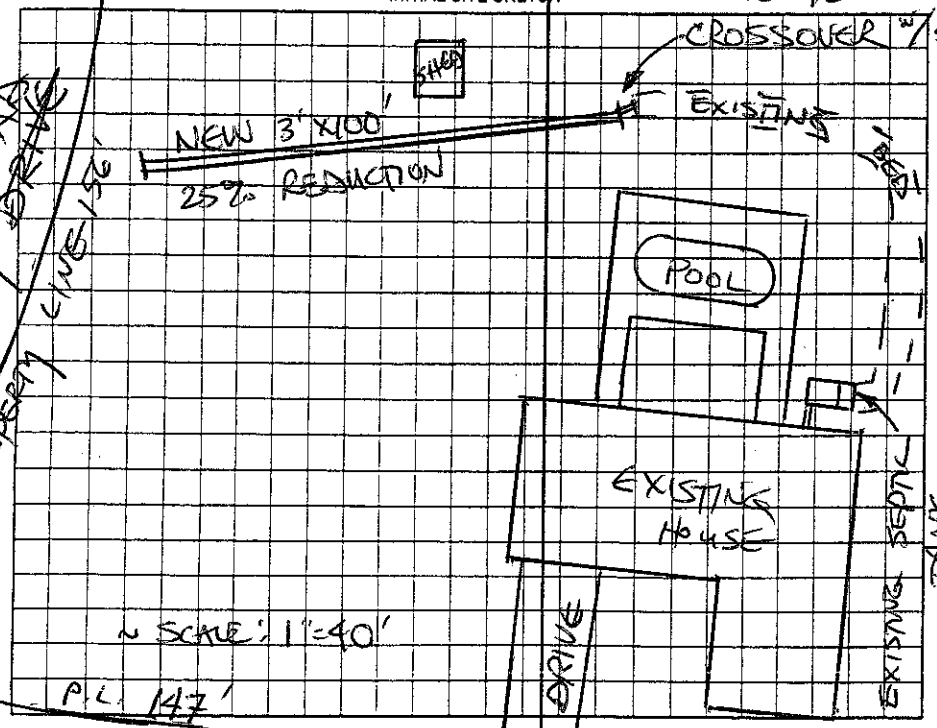

AS BUILT SKETCH

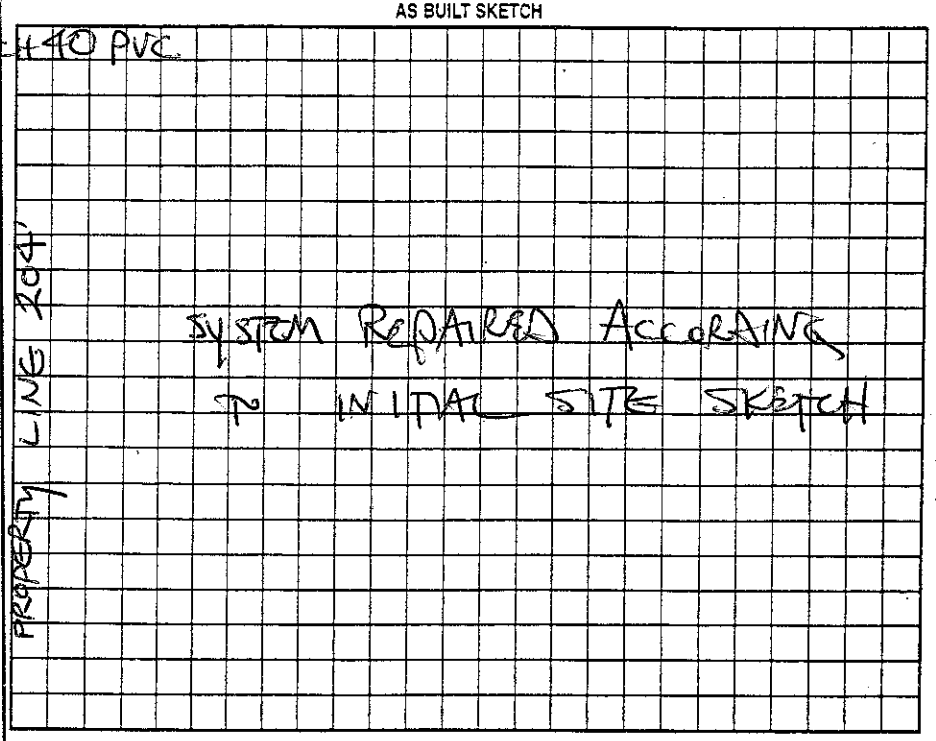

Permit can be suspended or revoked if any false information is supplied toward securing the permit/any unauthorized changes are made to the site/any unauthorized changes are made in the installation of the system. Improvement Permit with plat valid without expiration ☐ Improvement Permit with site plan valid for sixty months ☑ Authorization to Construct is valid for a period equal to that of Improvement Permit – not to exceed sixty months.

Signed: Kenneth Harris date 10-25-06 Installed by: A-1 BACKHOE

Improvement Permit by: STEVE HENDRICK P.L. 25 date 10-13-06 Operation Permit by: STEVE HENDRICK date 10-25-06

Authorization to Construct by: STEVE HENDRICK date 10-24-06 Existing System Inspection by: ____ date ____

HEALTH DEPT. COPY: WHITE OWNER COPY (FINAL): YELLOW OWNER COPY (INITIAL): PINK