IREDELL COUNTY HEALTH DEPARTMENT

STATESVILLE 704-878-5305 MOORESVILLE 704-664-5281

IMPROVEMENT PERMIT / CERTIFICATE OF COMPLETION / OPERATION PERMIT / EXISTING SYSTEM INSPECTION

PROPERTY DESCRIPTION NO. _____ DATE 6-4-96 TAX MAP NO. _____ Watershed: ☐ Yes ☑ No

OWNER OR CONTRACTOR Kevin Allan PHONE: Business _____ Home 876 4534

ADDRESS 129 Castle Creek

LOCATION 21N TL Shoemaker TL Castle Creek 600 l-left

SUBDIVISION Kingswood BLOCK / SECTION _____ LOT 32 LOT AREA 1/2 acre SITE CLASS PS DESIGN FLOW 360 L.T.A.R. .3

Septic Tank: 1000 EX Gallons; STB _____ Date _____

Pump Tank: _____ Gallons; PT _____ Date _____

Pump Make: _____ Model _____ Serial No. _____

Nitrification Field: No Fields 1 Square Feet 720 Linear Feet 240

No Lines 3 Trench Width 36" Max Trench Bottom Depth 36"

☐ New System ☑ Repair System Type: I, II, III, IV, V, VI

System Description: _____

Repair System Description: Gravity Chambers

Maintenance Agreement Required: ☐ Yes ☑ No

Gravel Depth N/A ☐ Slab ☐ Crawl Space ☑ Basement w/plumbing ☐ Basement wo/plumbing

☑ House/Mod. Home No. Bedrooms 3

☐ Mobile Home No. Bathrooms 2

☐ Business No. Employees _____

☐ Other _____


Water Supply: ☐ Individual ☐ Community ☑ Public

Comments: new Run Drain lines on contour of slope Remove large maple Tree which will be in area of

Comments: original System Installed 3-10-82 Foxfire Corp.

INITIAL SITE SKETCH New Drainfield

AS BUILT SKETCH

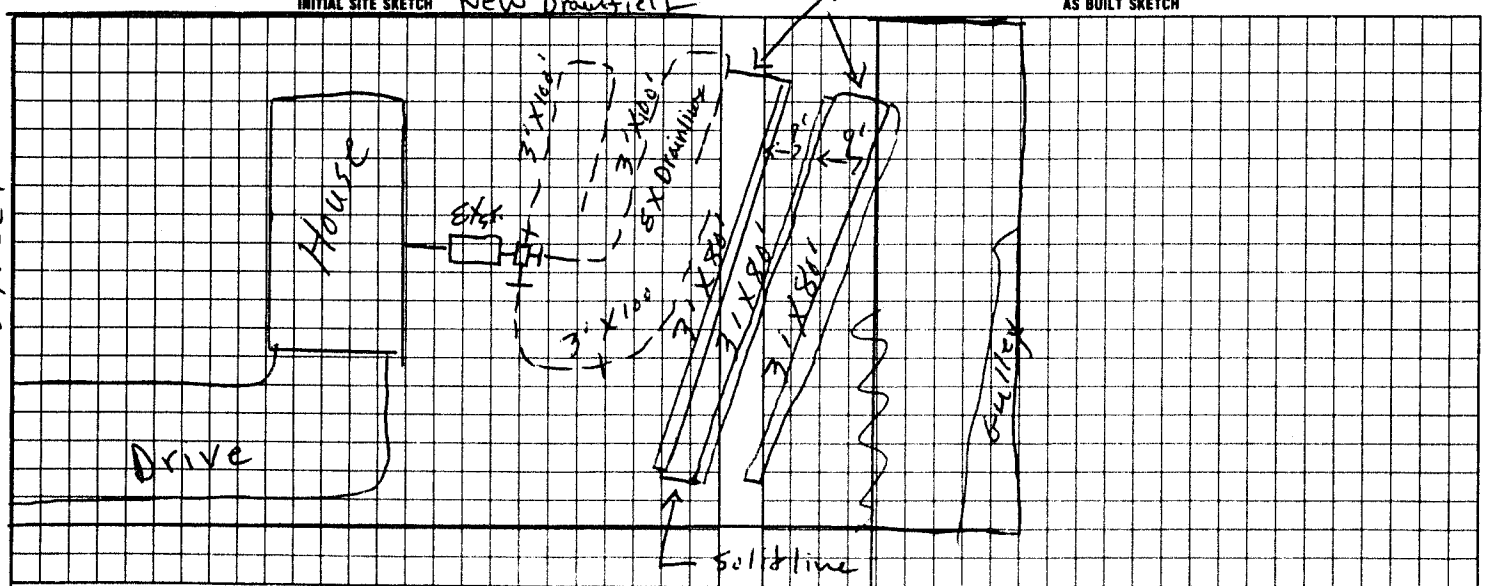

I understand that this permit can be suspended or revoked if any false information is supplied toward securing the permit/any unauthorized changes are made to the site/any unauthorized changes are made in the installation of the system.

Signed: X Kevin C Allen

Improvement Permit by: P. C. Moore date 6-4-96

Existing System Inspection by: P. C. Moore date 6-4-96

Installed by Steve Jordan

Certificate of Completion by _____ date _____

Operation Permit by P. C. Moore date 3-3-99

authorization to cont.

authorization to cont. EXPires 60 mos from issue

HEALTH DEPT. COPY WHITE | INSPECTION COPY (FINAL) GREEN | OWNER COPY (FINAL) YELLOW | INSPECTION COPY (INITIAL) PINK | OWNER COPY (INITIAL) GOLD