IREDELL COUNTY HEALTH DEPARTMENT

STATESVILLE 704-878-5305 MOORESVILLE 704-664-5281

IMPROVEMENT PERMIT / AUTHORIZATION TO CONSTRUCT / OPERATION PERMIT / EXISTING SYSTEM INSPECTION

PERMIT# 83871 PIN# 4746214848 DATE 2-2-00

OWNER OR CONTRACTOR CCS Inc. PHONE: Business 881 0510 Home

ADDRESS 130 Dobbs Drive Statesville

LOCATION 21N TL Rimmer Rd TR Fairgate 4th lot Rt.

SUBDIVISION Fairview Fm BLOCK / SECTION LOT 4 LOT AREA .63 acres SITE CLASS PS DESIGN FLOW 360 L.T.A.R. .33

Septic Tank: 1000 Gallons: STB 1017 Date 10-12-99

Pump Tank: Gallons; PT Date

Pump Make: Model Serial No.

Nitrification Field: No Fields 1 Square Feet 810 Linear Feet 270

No Lines 5 Trench Width 36" Max Trench Bottom Depth 36" Gravel Depth N/A

☑ New System ☐ Repair System Type: I. II. III. IV. V. VI

System Description: Gravity 2590 Reduct.

Repair System Description: Pump To Conv.

Maintenance Agreement Required: ☐ Yes ☑ No

☑ House/Mod. Home ☐ Mobile Home ☐ Business ☐ Other

No. Bedrooms 3 No. Bathrooms 2 No. Employees


Water Supply: ☐ Individual ☑ Public ☐ Community

☐ Slab ☑ Crawl Space ☐ Basement w/plumbing ☐ Basement wo/plumbing


Comments/Conditions: Permit Replaces one issued 10-12-99 House + Stub out were Placed Too Low To Get Gravity Conv. System out rear side of lot.

Comments/Conditions:

INITIAL SITE SKETCH

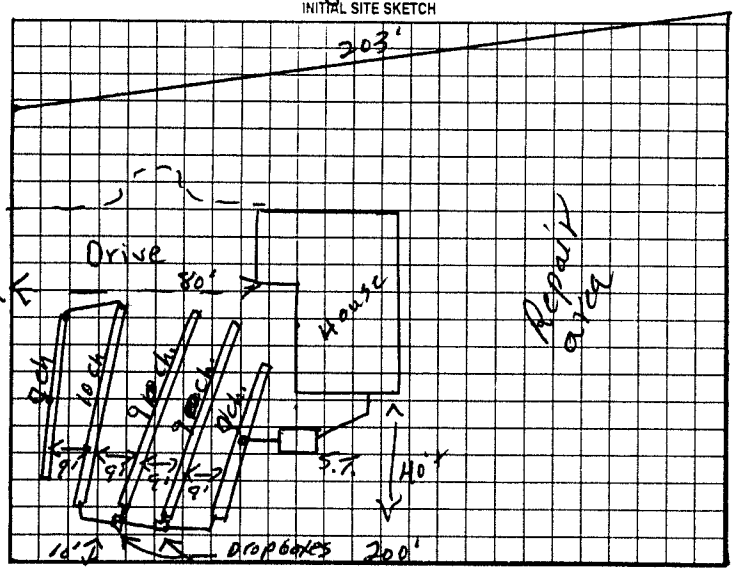

AS BUILT SKETCH

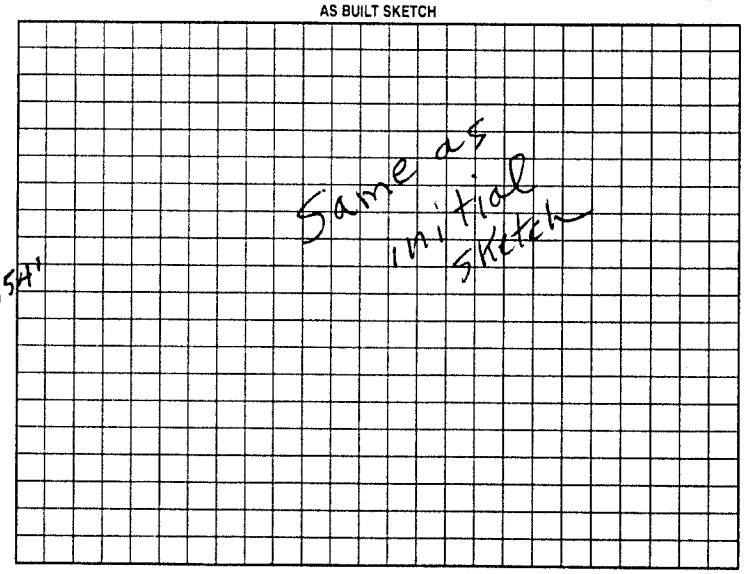

Permit can be suspended or revoked if any false information is supplied toward securing the permit/any unauthorized changes are made to the site/any unauthorized changes are made in the installation of the system. Improvement Permit with plat valid without expiration. Improvement Permit with site plan valid for sixty months. Authorization to Construct is valid for a period equal to that of Improvement Permit – not to exceed sixty months.

Signed [signature] date 2-3-00 Installed by: Craig Thompson

Improvement Permit by: P.C. Moore date 2-2-00 Operation Permit by: P.C. Moore date 2-3-00

Authorization to Construct by: P.C. Moore date 2-2-00 Existing System Inspection by: date

HEALTH DEPT. COPY: WHITE OWNER COPY (FINAL): YELLOW OWNER COPY (INITIAL): PINK