IREDELL COUNTY HEALTH DEPARTMENT

Statesville Phone TR 3-7271 Mooresville Phone NO 3-1271

PERMIT TO INSTALL SEPTIC TANK

Permit NO. _____ (Elsie Harris) Permit Date June 11 1960

Owner Zeno Dickson (owner) Address Statesville #4

Installed By S.E.& F. Address _____


Location of Property Hwy #21 North - across from Parks Garage on LH - Trailer

Tank		Capacity		Length of Lines		Fixtures	
Block	(✓)	800	( )	150'	( )	No. of Baths	(1)
Precast	( )	900	( )	175'	(✓)	Dishwasher	( )
		1000	( )	200'	( )	Garbage Grdr.	( )
		1100	( )	225'	( )	Auto-Washer	( )
		1200	( )	250'	( )	Other	_____
		Other 1500		Other	_____		

NOTIFY HEALTH DEPARTMENT AT LEAST EIGHT HOURS BEFORE TANK IS TO BE INSPECTED.

Final Inspection June 11 1960 Approved (✓) Disapproved ( )

Remarks _____

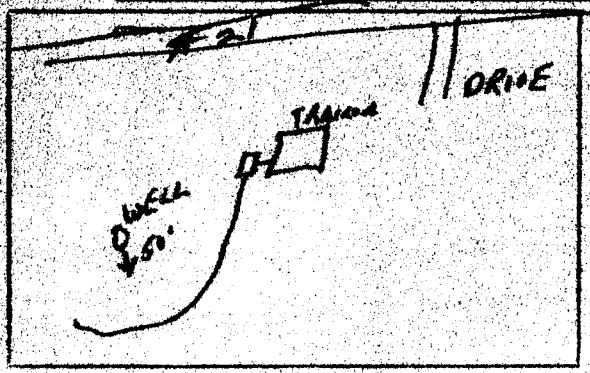

Sketch of Installation

Rafael A. Thomas

Sanitarian