IREDELL COUNTY HEALTH DEPARTMENT

Statesville Phone TR 3-7271 Mooresville Phone NO 3-1271

PERMIT TO INSTALL SEPTIC TANK

Permit No. 166 Permit Date 9-10 1921

Owner Hope Bros. Builders Inc Address Statesville, NC

Installed By Hope Bros. Address Statesville, NC

Location of Property Iredell Heights - (Road #1922)


No - 1

Tank		Capacity		Length of Lines		Fixtures	
Block	( )	1000	(✓)	225'	( )	No. of Baths	(4)
Precast	(✓)	1250	( )	250'	( )	Dishwasher	( )
		1500	( )	Other 300 ~~200~~		Garbage Grdr.	( )
		Other				Other	

NOTIFY HEALTH DEPARTMENT AT LEAST EIGHT HOURS BEFORE TANK IS TO BE INSPECTED.

Final Inspection 9-10 1921 Approved (✓) Disapproved ( )

Remarks Water Supply - Iredell Water Corp.

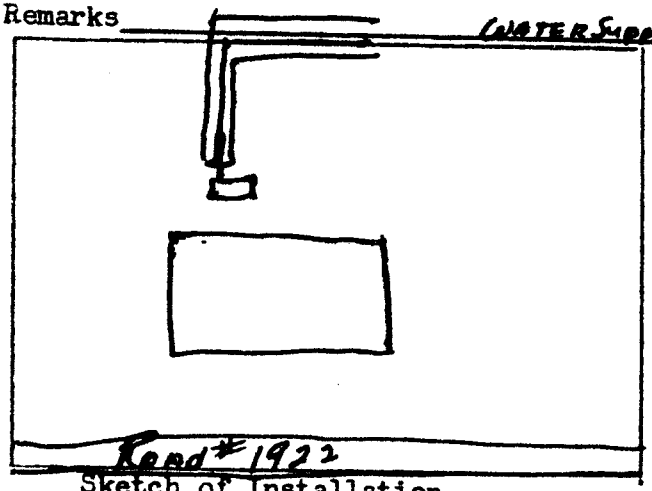

Sketch of Installation

Sanitarian