IREDELL COUNTY HEALTH DEPARTMENT

Statesville Phone TR 3-7271 — Mooresville Phone NO 3-1271

PERMIT TO INSTALL SEPTIC TANK

Permit No. 161 (Blackwell) — Permit Date _____ 19__

Owner David Blackwelder — Address Statesville

Installed By Hope Brothers — Address Statesville


Location of Property Iredell Heights Lot #2

Tank		Capacity		Length of Lines		Fixtures	
Block	( )	1000	( )	225'	( )	No. of Baths	(2)
Precast	(✓)	1250	( )	250'	( )	Dishwasher	( )
		1500	( )	Other 240		Garbage Grdr.	( )
		Other _____				Other Washer	

NOTIFY HEALTH DEPARTMENT AT LEAST EIGHT HOURS BEFORE TANK IS TO BE INSPECTED.

Final Inspection 9-8-1971 — Approved (✓) Disapproved ( )

Remarks Poor soil; could give trouble later

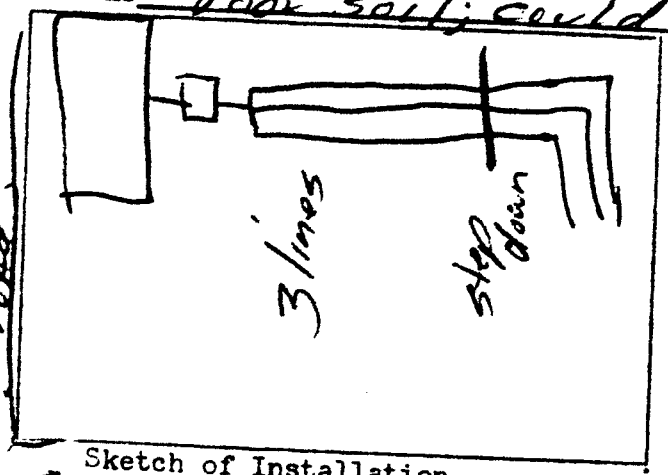

Sketch of Installation

Sanitarian