IREDELL COUNTY HEALTH DEPARTMENT

Statesville Phone TR 3-7271 Mooresville Phone NO 3-1271

PERMIT TO INSTALL SEPTIC TANK

Permit No. 203 Permit Date MARCH 23 1971

Owner HOPE BROS BUILDERS INC. Address STATESVILLE, N.C

Installed By Adams Septic Tank Serv. Address TAYLORSVILLE, N.C.

Location of Property IREDELL HEIGHTS


LOT # 708

Tank		Capacity		Length of Lines		Fixtures	
Block	( )	1000	(✓)	225'	( )	No. of Baths	(1½)
Precast	(✓)	1250	( )	250'	( )	Dishwasher	( )
		1500	( )	Other 300 90 sq ft.		Garbage Grdr.	( )
		Other				Other	

NOTIFY HEALTH DEPARTMENT AT LEAST EIGHT HOURS BEFORE TANK IS TO BE INSPECTED.

Final Inspection MARCH 23 1971 Approved (✓) Disapproved ( )

Remarks

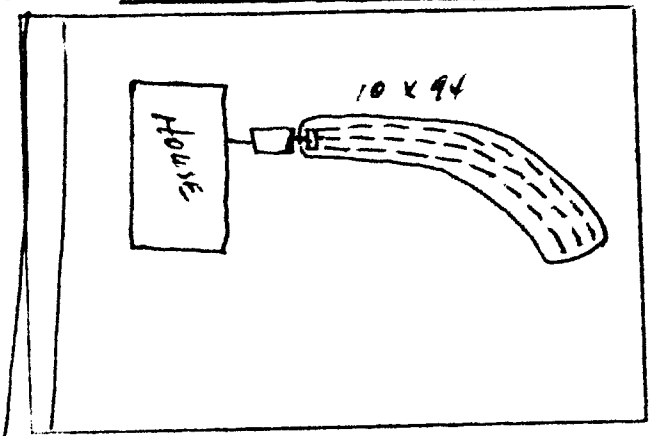

Sketch of Installation

Sanitarian