IREDELL COUNTY HEALTH DEPARTMENT

Statesville Phone TR 3-7271 Mooresville Phone NO 3-1271

PERMIT TO INSTALL SEPTIC TANK

Permit NO. _____ Permit Date 6 June 1960

Owner Steadman Realty Co #1 Address Iredell Heights

Installed By C Hoke Address R7

Location of Property on left in Iredell Heights


1st house F.H.A.# 38-093928

Tank		Capacity		Length of Lines		Fixtures	
Block	( )	800	( )	150'	( )	No. of Baths	( )
Precast	(✓)	900	( )	175'	( )	Dishwasher	( )
		1000	( )	200'	( )	Garbage Grdr.	( )
Load		1100	( )	225'	(✓)	Auto-Washer	( )
		1200	( )	250'	( )	Other	
		Other 1250		Other			

NOTIFY HEALTH DEPARTMENT AT LEAST EIGHT HOURS BEFORE TANK IS TO BE INSPECTED.

Final Inspection 6 June 1960 Approved ( ) Disapproved ( )

Remarks Well 100' back line 70' + Crossdrain

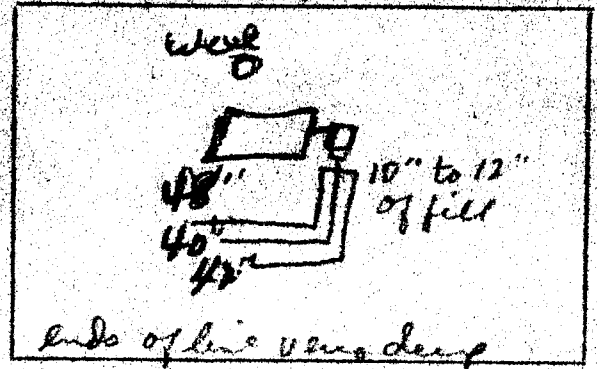

ends of line very deep

Sketch of Installation

ends of lines very deep. at tank very close to top of bank - all extra dirt was used to build up around tank and lines. (Ret)

Self appr.

Sanitarian