IREDELL COUNTY HEALTH DEPARTMENT

Statesville Phone TR 3-7271

Mooresville Phone NO 3-1271

PERMIT TO INSTALL SEPTIC TANK

Permit NO. _____ Permit Date July 12 1963

Owner Donald Cruckmore Address Sudell Heights

Installed By Roy Lentz Address


Location of Property Sudell Heights

Tank		Capacity		Length of Lines		Fixtures	
Block	( )	800	( )	150'	( )	No. of Baths	( )
Precast	( )	900	( )	175'	( )	Dishwasher	(1)
Poured		1000	(✓)	200'	( )	Garbage Grdr.	( )
		1100	( )	225'	( )	Auto-Washer	( )
		1200	( )	250'	(✓)	Other	( )
		Other	( )	Other	( )		

NOTIFY HEALTH DEPARTMENT AT LEAST EIGHT HOURS BEFORE TANK IS TO BE INSPECTED.

Final Inspection 7/12 1963 Approved (✓) Disapproved ( )

Remarks

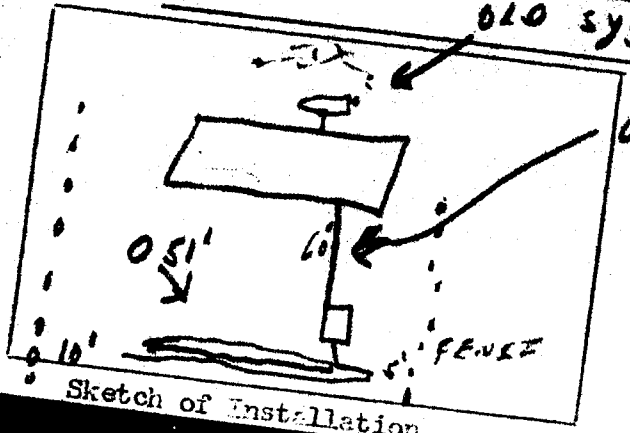

Sketch of Installation

Raymond A. Thomas

Sanitarian