IREDELL COUNTY HEALTH DEPARTMENT

STATESVILLE 704-878-5305 MOORESVILLE 704-664-5281

IMPROVEMENT PERMIT / AUTHORIZATION TO CONSTRUCT / OPERATION PERMIT / EXISTING SYSTEM INSPECTION

PERMIT # REPAIR PIN # 4746451579 DATE 8-14-09

OWNER or APPLICANT BARRY THOMAS PHONE: Business 704-880-6491 Home: 704-876-4761

OWNER or APPLICANT ADDRESS 186 SHUMAKER RD STATESVILLE NC 28625

LOCATION / DIRECTIONS 21 NORTH TO SHUMAKER ON RIGHT AT BOX # 186

SUBDIVISION IREDELL HEIGHTS BLOCK / SECTION LOT # 6 7 9 LOT AREA 100'x200' DESIGN FLOW 360 L.T.A.R.

Septic Tank 1000 Gallons: STB Precast Date 4/14/65?
Pump Tank Gallons: PT Date
Pump Make Model Serial #
Nitrification Field No Fields 1 No Lines 2 Linear Feet 250'
Trench Width Max. Trench Bottom Depth Gravel Depth

☐ New System ☒ Repair ☐ Expansion System Type I (II) III IV V VI
System Description:
Repair System Description: New Pipe/Gravel Encased
Maintenance Agreement Required ☐ YES ☒ NO
☒ GRAVITY ☐ PRESSURE


☒ Residence No. Bedrooms 3
☐ Business No. Persons
☐ Other No. Employees
☐ Slab ☒ Crawl Space
☐ Basement w/plumbing ☐ Basement w/o plumbing

Water Supply: ☐ Private ☒ Public ☐ Community

Comments / Conditions (1) Neighbors Maple Tree Roots Stopped Up Drainline. Section Dug out & replaced AS Drawn Below (2) New Tee Added in tank and distribution box added for future repair in front yard if necessary. (3) ROOT Killer

Comments / Conditions Recommended to keep roots out of system in future. (4) This Permit Serves As Notice of Violation and must be repaired within 30 days.

INITIAL SITE SKETCH

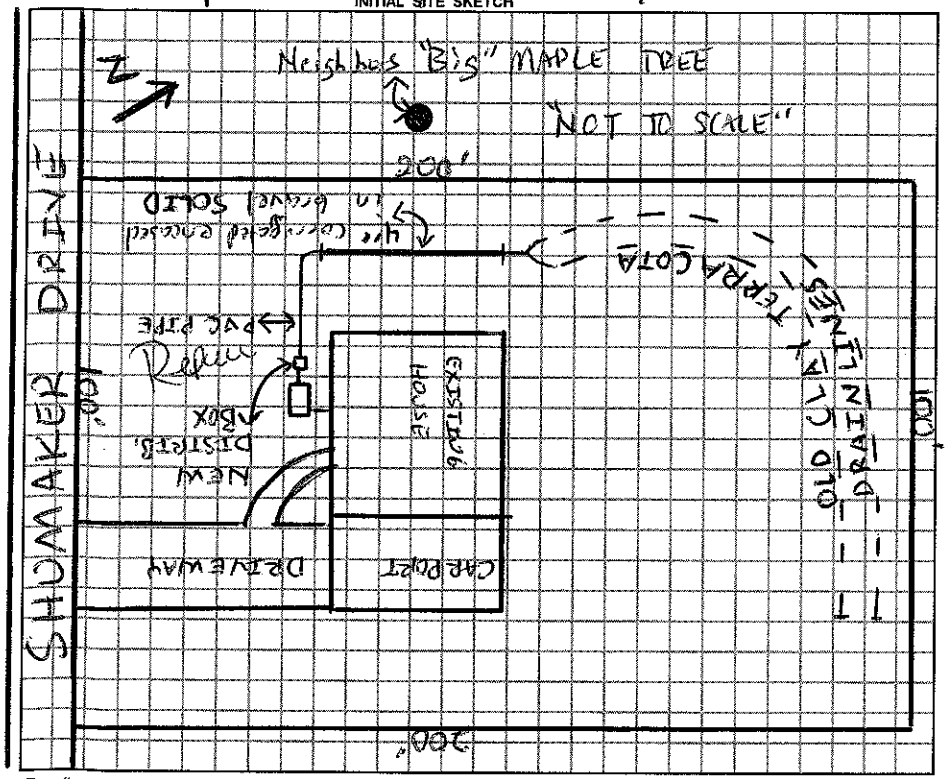

AS BUILT SKETCH

Permit can be suspended or revoked if any false information is supplied toward securing the permit / any unauthorized changes are made to the site / any unauthorized changes are made in the installation of the system.

☐ *IMPROVEMENT PERMIT w / plat valid without expiration.* ☐ *IMPROVEMENT PERMIT w / site plan valid for 60 mos.* ☐ *AUTHORIZATION TO CONSTRUCT valid for period equal to IMPROVEMENT PERMIT-not to exceed 60 mo.*

Owner / Applicant Signature: Barry N Thomas Date 8/14/09

Improvement Permit by: RS Date 8-14-09

Authorization to Construct by: RS Date 8-14-09

Installed by: WES LYTTON CONSTRUCTION

Operation Permit by: Date: 8-14-09

Existing System Inspected by: Date:

YOU SHOULD CONTACT A LOCATOR SERVICE PRIOR TO ANY EXCAVATION.

WHITE COPY Environmental Health YELLOW COPY (Final) Owner / Applicant PINK COPY (Initial) Owner / Applicant