4746-45-1749000

181 East Elsinore Dr.
Pinnacle Heights, Lots 819-824

IREDELL COUNTY HEALTH DEPARTMENT

Statesville Phone TR 3-7271 Mooresville Phone NO 3-1271

PERMIT TO INSTALL SEPTIC TANK

Permit No. 265 Permit Date 3/24 19 71

Owner Hope Brothers Address Statesville

Installed By Floyd Adams Address Taylorsville


Location of Property North #21 to rd. 1922. Turn back to right on rd. 1955. 1st house on right.

Tank		Capacity		Length of Lines		Fixtures	
Block	( )	1000	(✓)	225'	( )	No. of Baths	(✓)
Precast	( )	1250	( )	250'	( )	Dishwasher	( )
		1500	( )	Other 900 sq Ft.		Garbage Grdr.	( )
		Other				Other	

NOTIFY HEALTH DEPARTMENT AT LEAST EIGHT HOURS BEFORE TANK IS TO BE INSPECTED.

Final Inspection 3-24-1971 Approved (✓) Disapproved ( )

Remarks

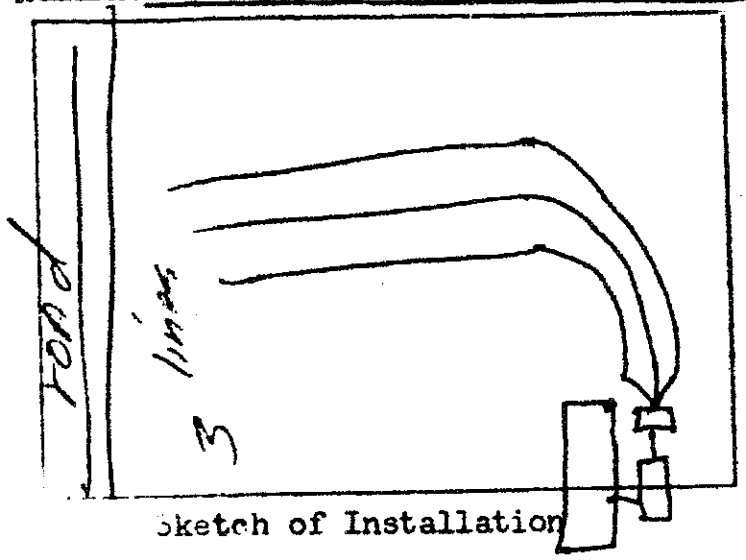

Sketch of Installation

Sanitarian