IREDELL COUNTY HEALTH DEPARTMENT

STATESVILLE 704-878-5305 MOORESVILLE 704-664-5281

IMPROVEMENT PERMIT / AUTHORIZATION TO CONSTRUCT / OPERATION PERMIT / EXISTING SYSTEM INSPECTION

PERMIT# Repair PIN# 4746-45-3070 DATE 12/23/04

OWNER OR CONTRACTOR Craig Sloan PHONE: Business - Home (704) 876-2165

ADDRESS 916 Olin Loop Road Olin, N.C. 28660

LOCATION Hwy 21 N. @ 6N Shumaker Drive, at corner of Debbie LN and Shumaker Drive

SUBDIVISION Iredell Heights BLOCK / SECTION - LOT 394 LOT AREA SITE CLASS. P5 DESIGN FLOW 360 L.T.A.R. Ex

Septic Tank: Ex Gallons; STB Date

Pump Tank: Gallons; PT Date

Pump Make: Model Eq. to Serial No.

Nitrification Field: No Fields 1 Square Feet 1200 Linear Feet 300

No Lines 5@60 Trench Width 36" Max Trench Bottom Depth 36" Gravel Depth N/A

☐ New System ☒ Repair System Type: I, II, III, IV, V, VI

System Description:

Repair System Description: Gravity 25% Reduction

Maintenance Agreement Required: ☐ Yes ☒ No

☒ House/Mod. Home No. Bedrooms 3

☐ Mobile Home No. Bathrooms 1

☐ Business No. Employees

☐ Other


☐ Slab ☒ Crawl Space ☐ Basement w/plumbing ☐ Basement wo/plumbing

Water Supply: ☐ Individual ☒ Public ☐ Community

Comments:/Conditions: (1) maintain correct setbacks (2) Rule 18A.1950 f.... 18in separation, with sewer line passing under the water line. See attached. (3) Cut willow Trees + Maple Trees that are in the system area.

Comments:/Conditions: NEW SANITARY TEE INSTALLED IN SEPTIC TANK

INITIAL SITE SKETCH (Not to Scale)

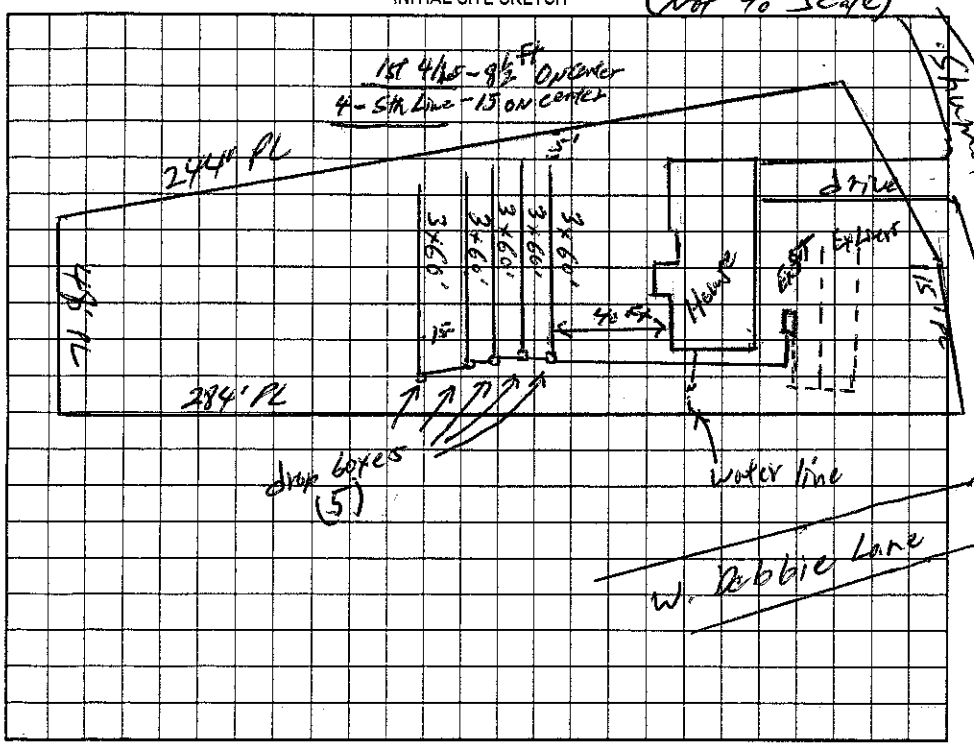

AS BUILT SKETCH

SYSTEM REPAIRED WITH TOP 2½ LINES USING 18" #5 CLEAN WASHED STONE ¾ BOTTOM 2½ LINES USING EEE-ZZZ FLO WITH PRIOR HEALTH DEPT APPROVAL

Permit can be suspended or revoked if any false information is supplied toward securing the permit/any unauthorized changes are made to the site/any unauthorized changes are made in the installation of the system. Improvement Permit with plat valid without expiration. Improvement Permit with site plan valid for sixty months. Authorization to Construct is valid for a period equal to that of Improvement Permit – not to exceed sixty months.

Signed: Crystal Sloan date 12-23-04

Improvement Permit by: William O. Johnson date 12/23/04

Authorization to Construct by: William O. Johnson date 12/23/04

Installed by: PIEDMONT BACKHOE

Operation Permit by: STEVE HENDRICK date 1-21-05

Existing System Inspection by: date

HEALTH DEPT. COPY: WHITE OWNER COPY (FINAL): YELLOW OWNER COPY (INITIAL): PINK