IREDELL COUNTY HEALTH DEPARTMENT

Statesville Phone TR 3-7271 Mooresville Phone NO 3-1271

PERMIT TO INSTALL SEPTIC TANK

Permit No. 177 Permit Date 9-29 1972

Owner Hope Bros Builders Inc Address Statesville, NC

Installed By Hope Bros. Address Statesville, NC

Location of Property 21 N - Left on Shoemaker Dr.


Iredell Heights - Lot No. 684

Tank		Capacity		Length of Lines		Fixtures	
Block	( )	1000	(✓)	225'	(✓)	No. of Baths	(2)
Precast	(✓)	1250	( )	250'	( )	Dishwasher	( )
		1500	( )	Other		Garbage Grdr.	( )
		Other				Other	

NOTIFY HEALTH DEPARTMENT AT LEAST EIGHT HOURS BEFORE TANK IS TO BE INSPECTED.

Final Inspection 9-29 1972 Approved (✓) Disapproved ( )

Remarks Jackson Water Corp.

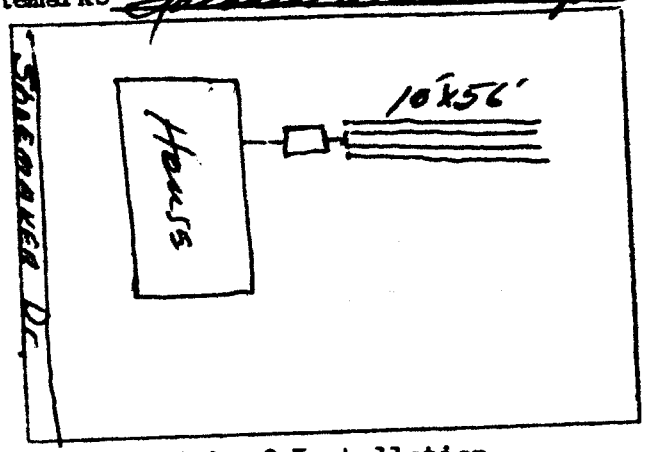

Sketch of Installation

Sanitarian