ICHD - ENVIRONMENTAL HEALTH DIVISION

Statesville Office (704) 878-5305 Mooresville Office (704) 660-3625

PERMIT # OSWP-2024-62139

SEPTIC: IMPROVEMENT PERMIT / AUTHORIZATION TO CONSTRUCT / OPERATION PERMIT / EXISTING SYSTEM

PIN # 4746-45-3770

APPLICANT / OWNER: Jordan Williams | APPLICANT ADDRESS: 2908 Florida Ave, Charlotte, NC 28205

SITE ADDRESS: 163 E EDISON DR, STATESVILLE, NC 28625 | PHONE: (980) 254-6928 | ALT. PHONE: (980) 254-6928


SITE DIRECTIONS: Hwy 21 Non E edison Site on left | SAP CONTROLLED: YES ☐ NO ☑

SUBDIVISION: Iredell Heights | SECTION: - | LOT #: 810 - 814 | LOT AREA: 125 x 200 | DESIGN FLOW: 360 | L.T.A.R.: Ext

Septic Tank: (gal) 1000	STB: 760	Date:	☐ New System ☑ Repair ☐ Expansion	System Type: II	☑ Residence	No. Bedrooms: 3	Water Supply: Municipal Water
Pump Tank: (gal)	PT:	Date:	System Description: -		☐ Business	No. Persons: 6	
Pump Make: unknown	Model:	Serial #:	Repair System Description: Tank Replacement		☐ Other	No. Employees:	
# Nitrification Fields: Ext	# Lines: Ext	Linear Ft.: Ext	Maintenance Agreement Required: ☐ YES ☑ NO		☐ Slab	☑ Crawl Space	
Trench Width: Ext	Trench Bottom Depth (Low side): Ext		Gravel Depth: Existing	☑ GRAVITY ☐ PRESSURE	☐ Basement w/ Plumbing	☐ Basement w/o Plumbing	

Comments / Conditions: pump / crush / fill old Tank Replace with new 1000 gallon Tank - Maintain min of 5ft from property line

INITIAL SITE SKETCH

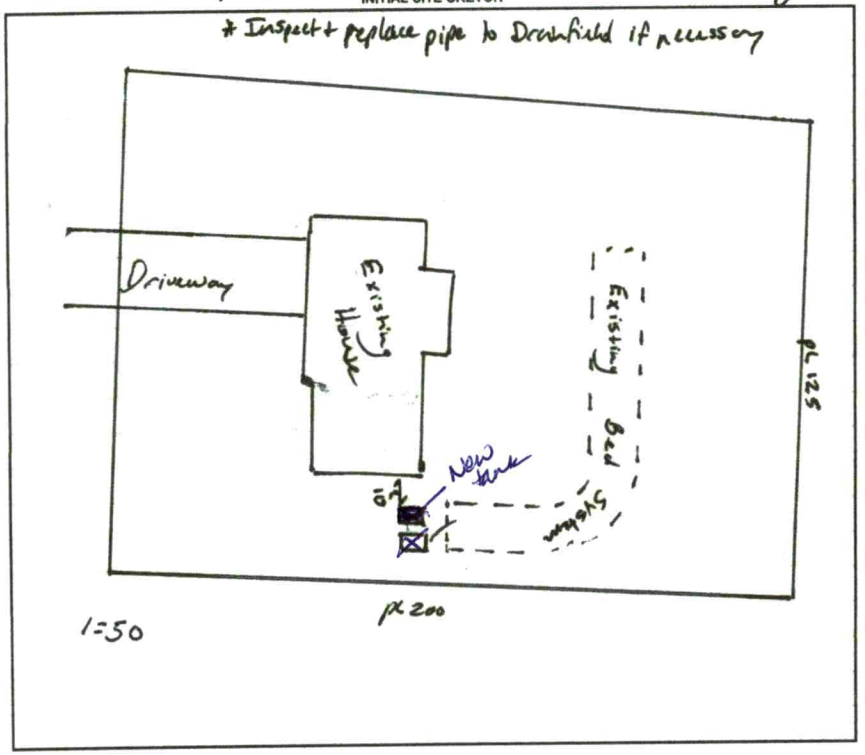

AS BUILT SKETCH

Tank set back in original location.

Permit can be suspended or revoked if any false information is supplied toward securing the permit / any unauthorized changes are made to the site / any unauthorized changes are made in the installation of the system. CONTACT A LOCATOR SERVICE PRIOR TO ANY EXCAVATION

☐ IMPROVEMENT PERMIT with plat valid without expiration. ☑ IMPROVEMENT PERMIT with site plan valid for 60 mos. ☑ AUTHORIZATION TO CONSTRUCT valid for period equal to IMPROVEMENT PERMIT--not to exceed 60 mo.

Owner / Applicant Signature: Online Signature | Date:

IMPROVEMENT PERMIT by: Bryant Bass | Date: 10-1-2024

AUTHORIZATION TO CONSTRUCT by: Bryant Bass | Date: 10-1-2024

Installed By: Abernathy

OPERATION PERMIT by: D. Weberg | Date: 10/31/24

Existing System Inspected By: | Date:

FOR SEPTIC FINAL INSPECTION CALL: 704-664-3703 BETWEEN 8am-9am the day the inspection is needed.

MW

ICHD - ENVIRONMENTAL HEALTH DIVISION

Statesville Office (704) 878-5305 Mooresville Office (704) 660-3625

PERMIT # OSWP-2024-62139

SEPTIC: IMPROVEMENT PERMIT / AUTHORIZATION TO CONSTRUCT / OPERATION PERMIT / EXISTING SYSTEM

PIN # 4746-45-3770

APPLICANT / OWNER: Jordan Williams | APPLICANT ADDRESS: 2908 Florida Ave, Charlotte, NC 28205

SITE ADDRESS: 163 E EDISON DR, STATESVILLE, NC 28625 | PHONE: (980) 254-6928 | ALT. PHONE: (980) 254-6928


SITE DIRECTIONS: Hwy 21 Won E edison Site on Left | SAP CONTROLLED: YES ☐ NO ☑

SUBDIVISION: Iredell Heights | SECTION: - | LOT #: 810-814 | LOT AREA: 125 x 200 | DESIGN FLOW: 360 | L.T.A.R.: Ext

Septic Tank: (gal) 1000	STB:	Date:	☐ New System ☑ Repair ☐ Expansion	System Type: II	☑ Residence	No. Bedrooms: 3	Water Supply: Municipal Water
Pump Tank: (gal)	PT:	Date:	System Description: -		☐ Business	No. Persons: 6	
Pump Make: unknown	Model:	Serial #:	Repair System Description: Tank Replacement		☐ Other	No. Employees:	
# Nitrification Fields: Ext	# Lines: Ext	Linear Ft.: Ext	Maintenance Agreement Required: ☐ YES ☑ NO		☐ Slab	☑ Crawl Space	
Trench Width: Ext	Trench Bottom Depth (Low side): Ext		Gravel Depth: Existing	☑ GRAVITY ☐ PRESSURE	☐ Basement w/ Plumbing	☐ Basement w/o Plumbing	

Comments / Conditions: pump/crush/fill old Tank Replace with new 1000 gallon Tank - Maintain min of 5ft from property line

INITIAL SITE SKETCH

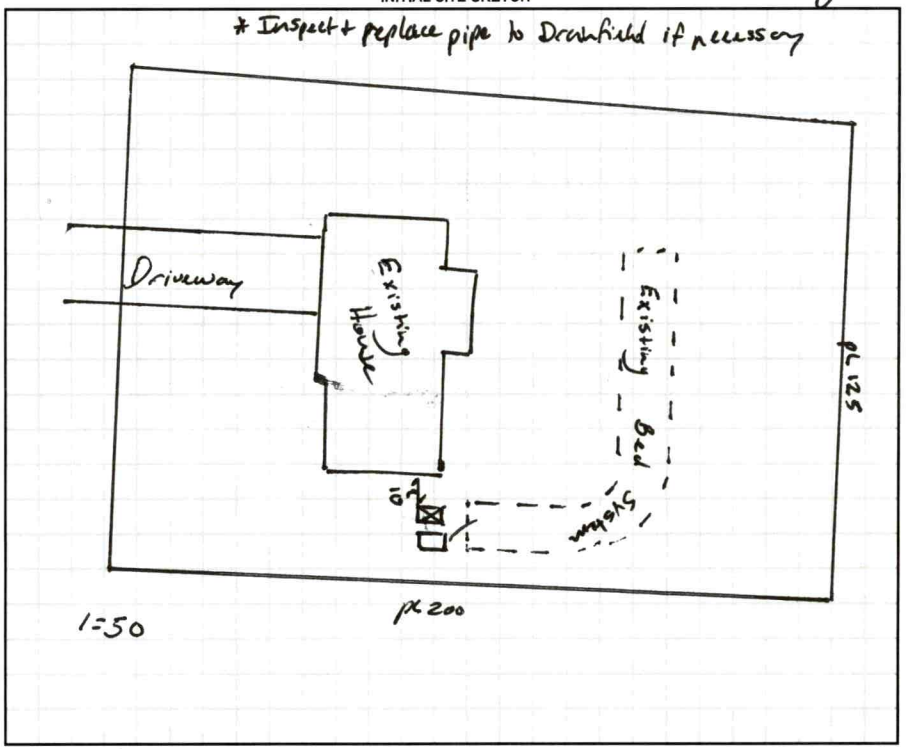

AS BUILT SKETCH

Permit can be suspended or revoked if any false information is supplied toward securing the permit / any unauthorized changes are made to the site / any unauthorized changes are made in the installation of the system. CONTACT A LOCATOR SERVICE PRIOR TO ANY EXCAVATION

☐ **IMPROVEMENT PERMIT with plat** valid without expiration. ☑ **IMPROVEMENT PERMIT with site plan** valid for 60 mos. ☑ **AUTHORIZATION TO CONSTRUCT** valid for period equal to **IMPROVEMENT PERMIT**--not to exceed 60 mo.

Owner / Applicant Signature: ☒ On line Signature | Date: | Installed By: Abernathy

IMPROVEMENT PERMIT by: Bryant Bass | Date: 10-1-2024 | OPERATION PERMIT by: - See attached | Date:

AUTHORIZATION TO CONSTRUCT by: Bryant Bass | Date: 10-1-2024 | Existing System Inspected By: | Date:

FOR SEPTIC FINAL INSPECTION CALL: 704-664-3703 BETWEEN 8am-9am the day the inspection is needed.

PERMIT SNAPSHOT REPORT OSWP-2024-62139 FOR IREDELL COUNTY

Permit Type	Environmental Health OSWP	**Project:**		**App Date:**	09/19/2024
Work Class:	EH Septic Permit	**District:**	Iredell County	**Exp Date:**	NOT AVAILABLE
Status:	PRIORITY PERMIT	**Square Feet:**	0.00	**Completed:**	NOT COMPLETED
Valuation:	$0.00	**Assigned To:**	Botkins, Ben	**Approval Expire Date:**	
Description:	Repair Tank.				

Parcel: 4746453770.000 Main	**Address:** 163 E Edison Dr Statesville, NC 28625 Main	**Zone:** R-20(Suburban Residential District)

Property Owner
Jordan Williams
Home: (980) 254-6928
Business: (980) 254-6928
Mobile: (980) 254-6928

Applicant/Authorized Agent
Jordan Williams
2908 Florida Ave
Charlotte, NC 28205
Home: (980) 254-6928
Business: (980) 254-6928
Mobile: (980) 254-6928

Permit Custom Fields

How is your site plan being submitted	Survey Plat	Septic Application/Permit Type	Repair	Does the site contain any jurisdictional wetlands	No
Non-domestic Sewage Generated	No	Other Public Agency	No	All proposed structure dimensions	structure is already there
Maximum Number of Bedrooms	3	If other Addition/Structure, please explain		Number of Occupants	6
Foundation Type	Crawl Space Foundation	Residential/Business/Other	Residential	Water Supply	Municipal Water
Desired Septic System Type	No Preference	If other septic system type, please explain	most affordable septic system for the home	Pump Make	unknown
# of Nitrification Fields		Model		Serial #	
System Description		Repair System Description		Comments/Conditions	
Additional Unique Setbacks Apply	No				

Attachment File Name	Added On	Added By	Attachment Group	Notes
Signature_Jordan_Williams_9/19/2024.jpg	09/19/2024 14:11	Williams, Jordan		Uploaded via CSS
Iredell Septic Authorize Ownwer.pdf	09/19/2024 16:26	Fleming, Latasha	Available Online	Authorization Form
Septic Permit_v1.pdf	09/19/2024 16:26	Williams, Jordan	Available Online	

Workflow Step / Action Name	Action Type	Start Date	End Date
Application Completeness Check v.1		09/19/2024 16:26	09/19/2024 16:27
Confirm application complete v.1	Generic Action		09/19/2024 16:27
Lot Readiness Verification v.1			
~~OSWP Septic Preliminary Site Visit v.1~~	Inspection		09/19/2024 16:28
OSWP Site Evaluation v.1	Inspection		
~~**Zoning Review v.1**~~			09/19/2024 16:26
~~Floodplain Admin Overview v.1~~	Task		09/19/2024 16:26
~~Iredell County Zoning Approval v.1~~	Task		09/19/2024 16:26
~~Issue Invoice v.1~~	Generic Action		09/19/2024 16:26
~~Fees Paid v.1~~	Generic Action		09/19/2024 16:26

PERMIT SNAPSHOT REPORT (OSWP-2024-62139)

Fees v.1	
Issue Invoice v.1	Generic Action
Fees Paid v.1	Generic Action
Issue Improvement Permit v.1	
Issue Invoice v.1	Generic Action
Fees Paid v.1	Generic Action
Issue Permit v.1	Generic Action
Permit Completion Process v.1	
Authorization to Construct Permit v.1	Create Sub Permit
Issue Authorization to Construct v.1	Generic Action