IREDELL COUNTY HEALTH DEPARTMENT

Statesville Phone TR 3-7271 Mooresville Phone No. 664-5281

PERMIT TO INSTALL SEPTIC TANK

Permit No. ____ Permit Date 5-14 1973

Owner Hope Bro Address Statesville N.C.

Installed By Hope Bro Address Statesville

Location of Property Iredell Heights on Rd # 1955 Lot # 800


Tank		Capacity		Length of Lines		Fixtures	
Block	( )	1000	(✓)	225'	( )	No. of Baths	(1½)
Precast	(✓)	1250	( )	250'	( )	Dishwasher	( )
		1500	( )	Other 300		Garbage Grdr.	( )
		Other ____		900 sq ft		Other ____	

NOTIFY HEALTH DEPARTMENT AT LEAST EIGHT HOURS BEFORE TANK IS TO BE INSPECTED.

Final Inspection 5-14 1973

Approved ( ) Disapproved ( )

Remarks Iredell Water Corp

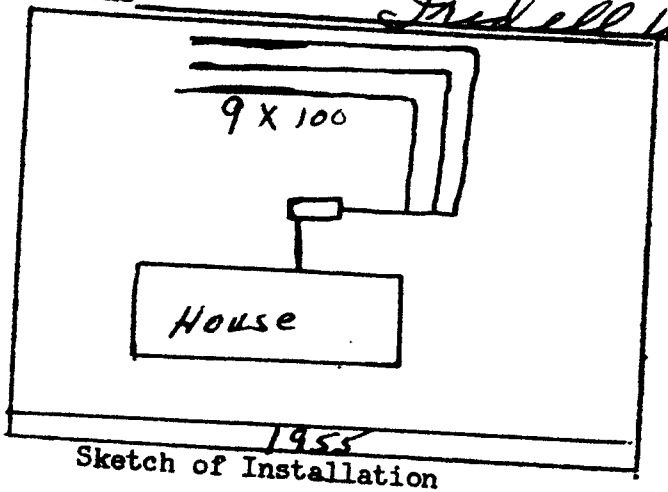

Sketch of Installation

E. A. Stevenson

Sanitarian