IREDELL COUNTY HEALTH DEPARTMENT

STATESVILLE 704-878-5305 MOORESVILLE 704-664-5281

IMPROVEMENT PERMIT / AUTHORIZATION TO CONSTRUCT / OPERATION PERMIT / EXISTING SYSTEM INSPECTION

PERMIT# REPAIR PIN# 4746-45-4393 DATE 5-4-07

OWNER OR APPLICANT MICHAEL H. MILLER PHONE: Business 704-876-0961 Home 704-252-2744

ADDRESS 160 MEADOW OAKS DRIVE STATESVILLE NC 28625

LOCATION US 21 NORTH, TL STHMAKER DRIVE, 0.3 MILE ON RIGHT AT BOX # 168

SUBDIVISION IREDELL HEIGHTS BLOCK / SECTION ____ LOT 692-695 SOT AREA / LIMITED SITE CLASS. PS DESIGN FLOW 360 L.T.A.R. 0.30 GPD/FT²

Septic Tank: EXISTING Gallons: STB ____ Date ____

Pump Tank: ____ Gallons: PT ____ Date ____

Pump Make: ____ Model ____ Serial No. ____

Nitrification Field: No Fields 1 Square Feet EST 720 Linear Feet 180

No Lines TWO Trench Width 36" Max Trench Bottom Depth 36"

☐ New System ☑ Repair ☐ Expansion System Type: I II III IV V VI

System Description: ____

Repair System Description: 25% REDUCTION, GRAVITY

Maintenance Agreement Required: ☐ Yes ☒ No

Gravel Depth N/A ☑ Gravity ☐ Pressure

☐ House/Mod. Home No. Bedrooms 3

☐ Mobile Home No. Persons ____

☐ Business No. Employees ____

☐ Other ____


☐ Slab ☑ Crawl Space ☐ Basement w/plumbing ☐ Basement wo/plumbing

Water Supply: ☐ Individual ☑ Public ☐ Community


Comments:/Conditions: ① INSTALL NEW 25% REDUCTION DRAINFIELD AS SHOWN ON CONTOUR USING SERIAL DISTRIBUTION ② THIS PERMIT SERVES AS "NOTICE OF VIOLATION" - TO BE REPAIRED BY 6-8-07

Comments:/Conditions:

INITIAL SITE SKETCH

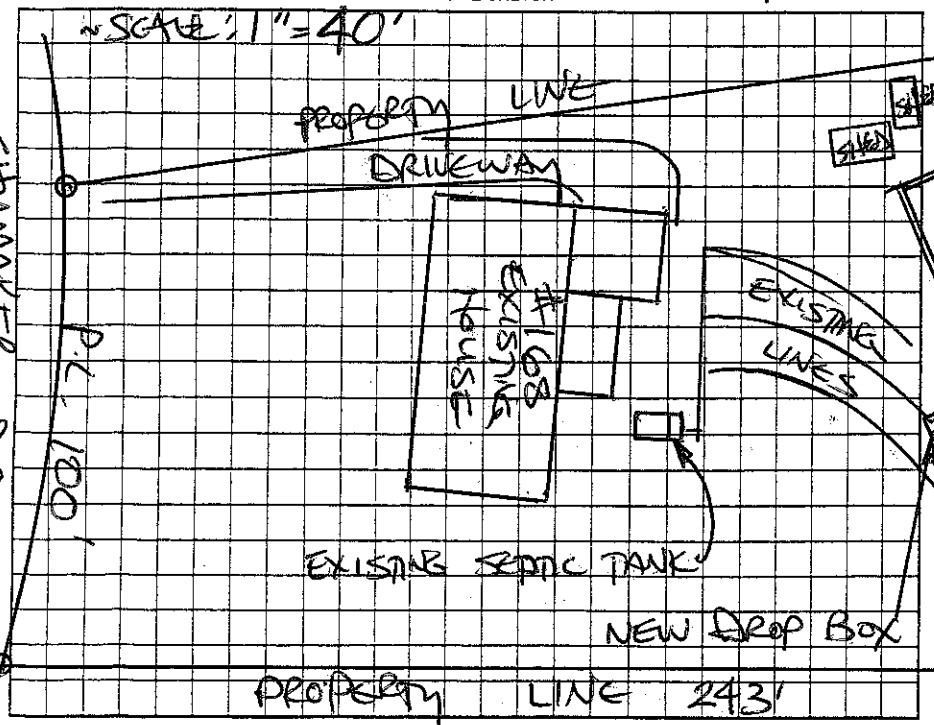

AS BUILT SKETCH

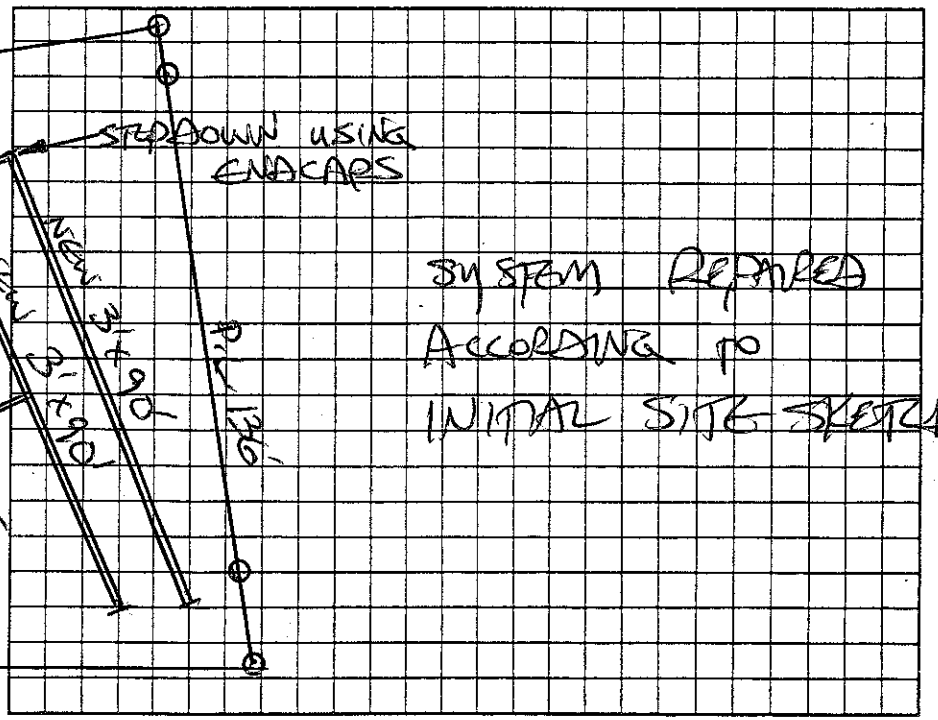

Permit can be suspended or revoked if any false information is supplied toward securing the permit/any unauthorized changes are made to the site/any unauthorized changes are made in the installation of the system. Improvement Permit with plat valid without expiration ☐ Improvement Permit with site plan valid for sixty months ☑ Authorization to Construct is valid for a period equal to that of Improvement Permit – not to exceed sixty months.

Signed: Michael H Miller date 5-4-07 Installed by: DANNY LAMBERTH GRADING

Improvement Permit by: STEVE HEDRICK date MAY 4, 07 Operation Permit by: STEVE HEDRICK date 5-30-07

Authorization to Construct by: STEVE HEDRICK date MAY 4, 07 Existing System Inspection by: ____ date ____

HEALTH DEPT. COPY: WHITE OWNER COPY (FINAL): YELLOW OWNER COPY (INITIAL): PINK