IREDELL COUNTY HEALTH DEPARTMENT

Statesville Phone TR 3-7271 Mooresville Phone NO 3-1271

PERMIT TO INSTALL SEPTIC TANK

Permit NO. Steadman Bld Co. Permit Date Oct 23 1962

Owner Childers Address Shumaker Dr.

Installed By C Hoke Address R7

Location of Property Ardell Heights - 3rd on Rt. lots


692 - 693 - 694 - 695 - Case # 94582

Tank	Capacity	Length of Lines	Fixtures
Block ( )	800 ( )	150' ( )	No. of Paths (2)
Precast (✓)	900 ( )	175' ( )	Dishwasher ( )
	1000 (✓)	200' ( )	Garbage Grdr. ( )
wash	1100 ( )	225' (✓)	Auto-Washer (✓)
	1200 ( )	250' ( )	Other
	Other	Other	

NOTIFY HEALTH DEPARTMENT AT LEAST EIGHT HOURS BEFORE TANK IS TO BE INSPECTED.

Final Inspection 10-23 62 Approved (✓) Disapproved ( )

Remarks FHA or G.I. -Well 100'

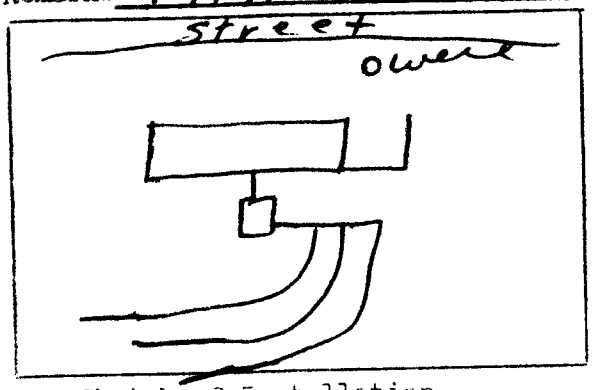

Sketch of Installation

Rut

Sanitarian