IREDELL COUNTY HEALTH DEPARTMENT

Statesville Phone TR 3-7271 Mooresville Phone No. 664-5281

PERMIT TO INSTALL SEPTIC TANK

Permit No. 198 Permit Date 10-12 19 72

Owner BLDR. Hope Bros. Builders Inc. Address Statesville N.C.

Installed By Hope Bros. Address Statesville, NC

Location of Property Iredell Heights


Shoemaker Dr. Lot # 688

Tank		Capacity		Length of Lines		Fixtures	
Block	( )	1000	(✓)	225'	(✓)	No. of Baths	(1½)
Precast	(✓)	1250	( )	250'	( )	Dishwasher	( )
		1500	( )	Other		Garbage Grdr.	( )
		Other				Other	

NOTIFY HEALTH DEPARTMENT AT LEAST EIGHT HOURS BEFORE TANK IS TO BE INSPECTED.

Final Inspection 10-12 1972 Approved (✓) Disapprcved ( )

Remarks Iredell Water Corp

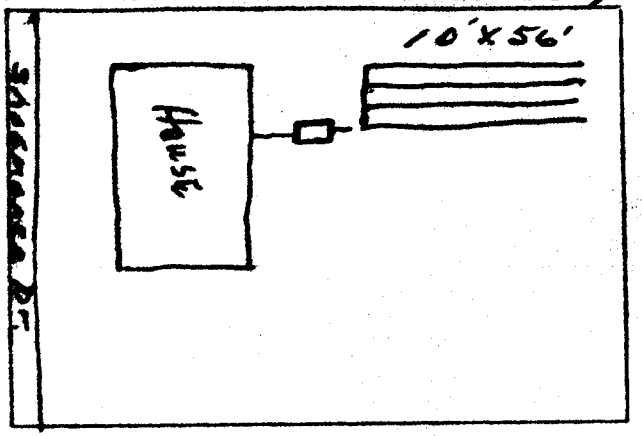

Sketch of Installation

Sanitarian