IREDELL COUNTY HEALTH DEPARTMENT

THIS PERMIT VOIDS EXPIRED PERMIT ISSUED 7-19-97

STATESVILLE 704-878-5305 MOORESVILLE 704-664-5281

IMPROVEMENT PERMIT / AUTHORIZATION TO CONSTRUCT / OPERATION PERMIT / EXISTING SYSTEM INSPECTION

PERMIT# REPAIR PIN# 4746-45-4996 DATE 11-19-02

OWNER OR CONTRACTOR RICKY L. HORNE PHONE: Business 704-929-0531 Home

ADDRESS 169 EAST EDISON DRIVE STATESVILLE NC 28625-8935

LOCATION US 21 North, TL EAST EDISON DRIVE, 3RD House on RIGHT PAST LORAINMORE DRIVE

SUBDIVISION IREDELL HEIGHTS BLOCK / SECTION LOT 631-639 LOT AREA LIMITED SITE CLASS PS DESIGN FLOW 480 L.T.A.R. EXISTING

Septic Tank: EXISTING Gallons; STB Date

Pump Tank: Gallons; PT Date

Pump Make: Model Serial No.

Nitrification Field: No Fields 1 Square Feet 630 Linear Feet 210

No Lines THREE Trench Width 36" Max Trench Bottom Depth 36" Gravel Depth (18")

☐ New System ☑ Repair System Type: I II III IV V VI

System Description: CONVENTIONAL, GRAVITY

Repair System Description: CONVENTIONAL, GRAVITY

Maintenance Agreement Required: ☐ Yes ☑ No

☐ Slab ☑ Crawl Space ☐ Basement w/plumbing ☐ Basement wo/plumbing

☑ House/Mod. Home No. Bedrooms 4

☐ Mobile Home No. Bathrooms 2

☐ Business No. Employees


☐ Other

Water Supply: ☐ Individual ☑ Public ☐ Community


Comments/Conditions: INSTALL NEW DROP BOXES INTERSECTING OLD LINE AT LOCATION SHOWN FEEDING ONE LINE EACH USING 18" STONE

Comments/Conditions: THIS PERMIT SERVES AS "NOTICE of VIOLATION", SYSTEM TO BE REPAIRED BY 12-19-02.

INITIAL SITE SKETCH

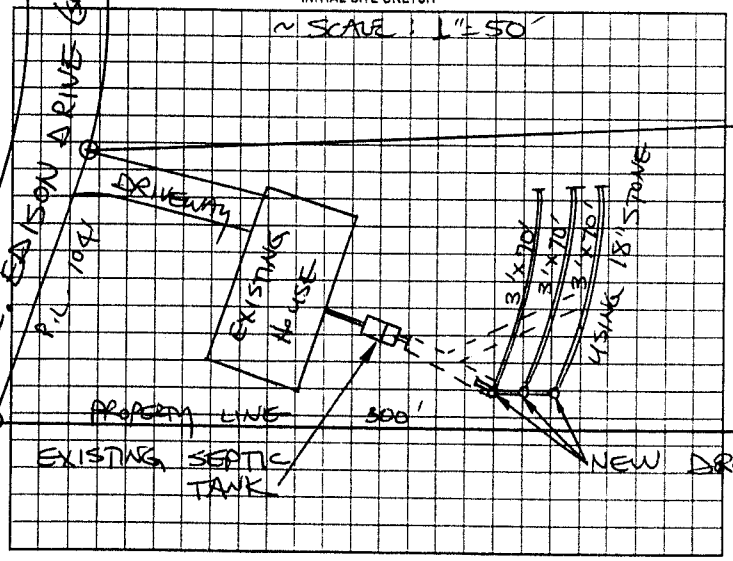

AS BUILT SKETCH

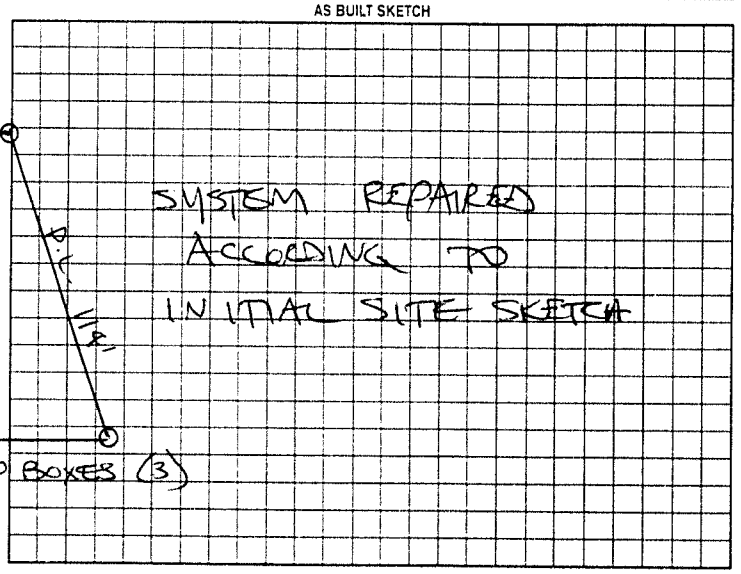

Permit can be suspended or revoked if any false information is supplied toward securing the permit/any unauthorized changes are made to the site/any unauthorized changes are made in the installation of the system. Improvement Permit with plat valid without expiration. Improvement Permit with site plan valid for sixty months. Authorization to Construct is valid for a period equal to that of Improvement Permit – not to exceed sixty months.

Signed: X [signature] date 1/15-03 Installed by: STEVE JORDAN

Improvement Permit by: STEVE HENDRICK date 11-19-02 Operation Permit by: STEVE HENDRICK date 12-12-02

Authorization to Construct by: STEVE HENDRICK date 11-19-02 Existing System Inspection by: date

HEALTH DEPT. COPY WHITE OWNER COPY (FINAL) YELLOW OWNER COPY (INITIAL) PINK