IREDELL COUNTY HEALTH DEPARTMENT

Statesville Phone TR 3-7271 Mooresville Phone NO 3-1271

PERMIT TO INSTALL SEPTIC TANK

Permit NO. Steadman Bld. Co. Permit Date 5-9- 1962

Owner Carl M White Address Shumaker Dr.

Installed By C Hoke Address R 7

Location of Property Iredell Hghts. on Right

Lots 696-697-698-699 FHA-VA#91384


Tank	Capacity	Length of Lines	Fixtures
Block ( )	800 ( )	150' ( )	No. of Baths (1)
Precast (✓)	900 ( )	175' ( )	Dishwasher ( )
	1000 (✓)	200' ( )	Garbage Grdr. ( )
	1100 ( )	225' (✓)	Auto-Washer (✓)
	1200 ( )	250' ( )	Other
	Other	Other	

Each

NOTIFY HEALTH DEPARTMENT AT LEAST EIGHT HOURS BEFORE TANK IS TO BE INSPECTED.

Final Inspection 5-9 1962 Approved (✓) Disapproved ( )

Remarks well 100' V.A. or F.H.A.

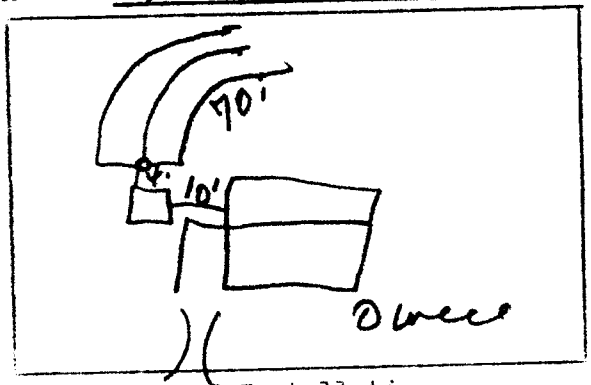

Sketch of Installation

Sanitarian