IREDELL COUNTY HEALTH DEPARTMENT

Statesville Phone TR 3-7271 Mooresville Phone No. 664-5281

PERMIT TO INSTALL SEPTIC TANK

Permit No. ~~/~~ Original - Lobeat Phillips Permit Date 4-18 1973

Owner Howard HEPLER Address Rt 9 Statesville, NC

Installed By Ray LENTZ Address Rt 5 Statesville.


Location of Property 21 N - LEFT on Shoemaker Dr. to IREDELL HEIGHTS - 4TH House on Rt Shoemaker Dr.

Tank	Capacity		Length of Lines		Fixtures	
Block ( )	1000	( )	225'	( )	No. of Baths	( )
Precast REPAIR	1200	( )	250'	( )	Dishwasher	( )
	1500	( )	Other 150'		Garbage Grdr.	( )
	Other				Other	

NOTIFY HEALTH DEPARTMENT AT LEAST EIGHT HOURS BEFORE TANK IS TO BE INSPECTED.

Final Inspection _____ 19___ Approved (✓) Disapproved ( )

Remarks _____

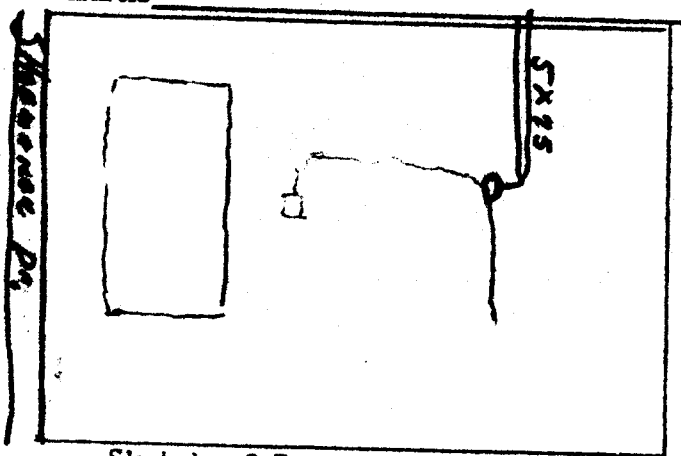

Sketch of Installation

Glenn Todd
Sanitarian