IREDELL COUNTY HEALTH DEPARTMENT - *ENVIRONMENTAL HEALTH* ☐ STATESVILLE OFFICE 704-878-5305 ☐ MOORESVILLE OFFICE 704-664-5281

IMPROVEMENT PERMIT / AUTHORIZATION TO CONSTRUCT / OPERATION PERMIT / EXISTING SYSTEM INSPECTION

PERMIT # 173530 PIN # 4746477343 DATE 7-10-12

OWNER Regina Cecil APPLICANT: Dixieland Inc. PHONE: Home/Cell # 704-876-6162 Business # N/A

SITE ADDRESS 219 Houpe Rd. Statesville OWNER / APPLICANT ADDRESS 133 Redemption Rd. Statesville

SITE DIRECTIONS 21N, Left on Houpe Rd.; Property on left

SUBDIVISION Bakers Estates BLOCK / SECTION N/A LOT # #1 LOT AREA 2.319 acres DESIGN FLOW 360 gpd L.T.A.R. 0.25

Septic Tank 1000 Gallons: STB 1000 Date 1-17-12 ☑ New System ☐ Repair ☐ Expansion System Type I II (III) IV V VI ☑ Residence No. Bedrooms 3 Water Supply

Pump Tank ____ Gallons: P T ____ Date ____ System Description: 25% Reduction ☐ Business No. Persons ____ ☐ Private


Pump Make ____ Model ____ Serial # ____ Repair System Description: 25% Reduction (Pump) ☐ Other No. Employees ____ ☑ Public

No. Nitrification Fields: 1 No. Lines 4 Linear Feet 360 Maintenance Agreement Required ☐ YES ☑ NO ☐ Slab ☐ Crawl Space ☐ Community

Trench Width 36" Max. Trench Bottom Depth 36" Gravel Depth N/A ☑ GRAVITY ☐ PRESSURE ☑ Basement w/plumbing ☐ Basement w/o plumbing

Comments / Conditions: Install 25% Reduction system on Contour with Serial distribution.

INITIAL SITE SKETCH

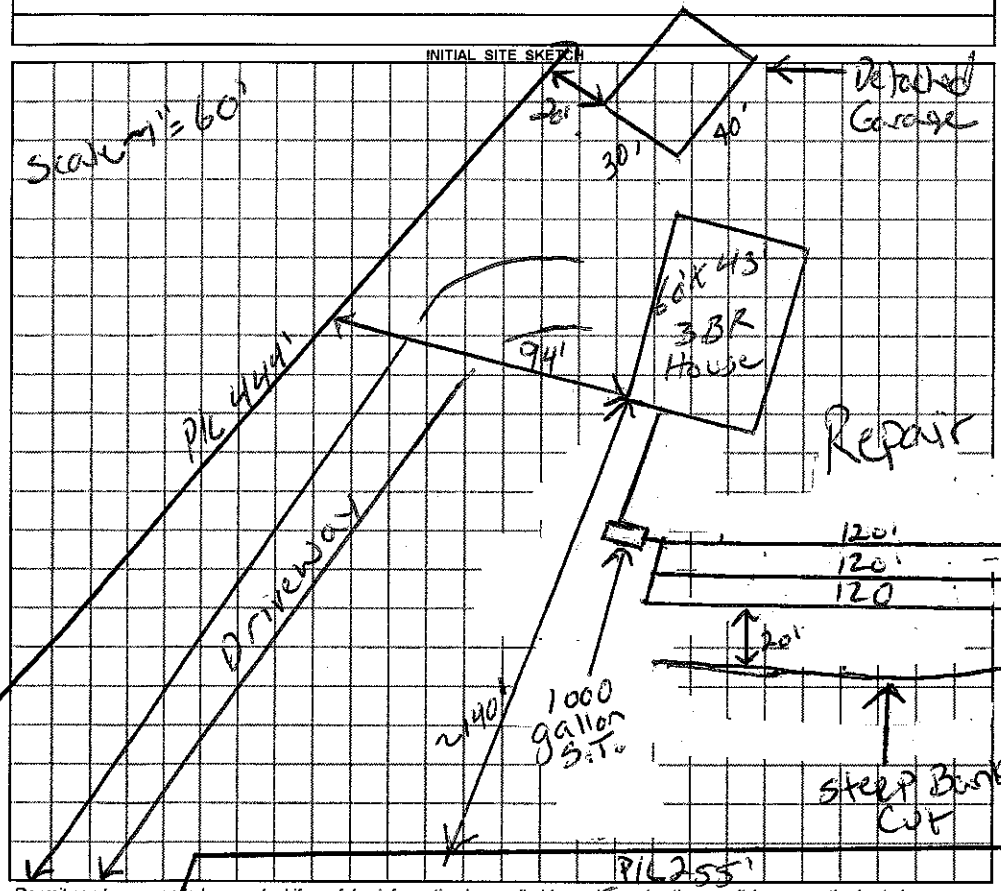

AS BUILT SKETCH

- Red Polylok Riser installed
- Quick 4 Chambers
- 2" PVC Septic tank marker
- Installed as drawn

Permit can be suspended or revoked if any false information is supplied toward securing the permit / any unauthorized changes are made to the site / any unauthorized changes are made in the installation of the system.

☐ ***IMPROVEMENT PERMIT*** with plat valid without expiration. ☑ ***IMPROVEMENT PERMIT*** with ~~plat valid without expiration~~ site plan valid 60 mo. ☑ ***AUTHORIZATION TO CONSTRUCT*** valid for period equal to IMPROVEMENT PERMIT--not to exceed 60 mo.

Owner / Applicant Signature: Ginger Dowdle Date 7/18/12 Installed by: Piedmont Backhoe

IMPROVEMENT PERMIT by: Justin Henderson REHS Date 7-10-12 OPERATION PERMIT by: Justin Henderson REHS Date 10-30-12

AUTHORIZATION TO CONSTRUCT by: Justin Henderson REHS Date 7-10-12 Existing System Inspected by: ____ REHS Date ____

YOU SHOULD CONTACT A LOCATOR SERVICE PRIOR TO ANY EXCAVATION

White Copy – Environmental Health YELLOW COPY (Final) Owner / Applicant PINK COPY (Initial) Owner / Applicant