IREDELL COUNTY HEALTH DEPARTMENT (C1)

STATESVILLE 704-878-5305 MOORESVILLE 704-664-5281

IMPROVEMENT PERMIT / AUTHORIZATION TO CONSTRUCT / OPERATION PERMIT / EXISTING SYSTEM INSPECTION

(C1)

PERMIT# 139565 PIN# 4746-53-4235, 001 7451 DATE 12-21-06

OWNER OR CONTRACTOR PHILLIP & BARBARA LAMBARDI PHONE: Business c/o 709-902-0574 Home 508-668-7361

ADDRESS 4 MARQUERITE RD, WALPOLE, MA 02051

LOCATION US21 NORTH, TR JANE SOWERS ROAD, TR LITTLE JOHN ROAD, 3RD LOT ON RIGHT

SUBDIVISION SILKWOOD FOLES BLOCK / SECTION II LOT 1 LOT AREA 0.544 ACRE SITE CLASS. P3 DESIGN FLOW 360 L.T.A.R. 0.225 GPD/FT²

Septic Tank: 1000 Gallons; STB 1012 Date 3-10-07
Pump Tank: _____ Gallons; PT _____ Date _____
Pump Make: _____ Model _____ Serial No. _____
Nitrification Field: No Fields 1 Square Feet ~~ER~~ TO 1600 Linear Feet 400
No Lines FIVE Trench Width 36" Max Trench Bottom Depth 36" Gravel Depth N/A

☑ New System ☐ Repair System Type: I II III IV V VI
System Description: 25% REDUCTION, GRAVITY
Repair System Description: 50% REDUCTION, LOW PRESSURE
Maintenance Agreement Required: ☐ Yes ☑ No


☑ House/Mod. Home ☐ Mobile Home ☐ Business ☐ Other
No. Bedrooms 3 No. Bathrooms ____ No. Employees ____
☐ Slab ☑ Crawl Space ☐ Basement w/plumbing ☐ Basement wo/plumbing

Water Supply: ☐ Individual ☑ Public ☐ Community


Comments/Conditions: REMOVE EXISTING FIELD TERRACE. INSTALL 25% REDUCTION SYSTEM ON CONTOUR AS FLAGGED ON SITE

Comments/Conditions: Filter installed / Marker on septic tank. Installed panel-to-panel - no drop-boxes.

INITIAL SITE SKETCH

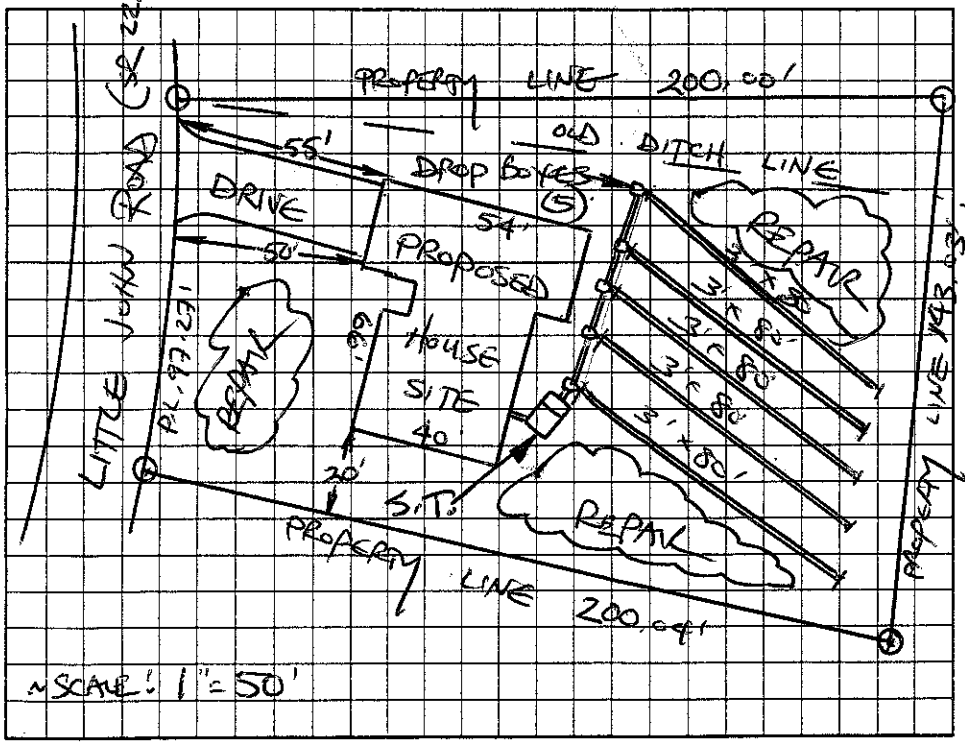

AS BUILT SKETCH

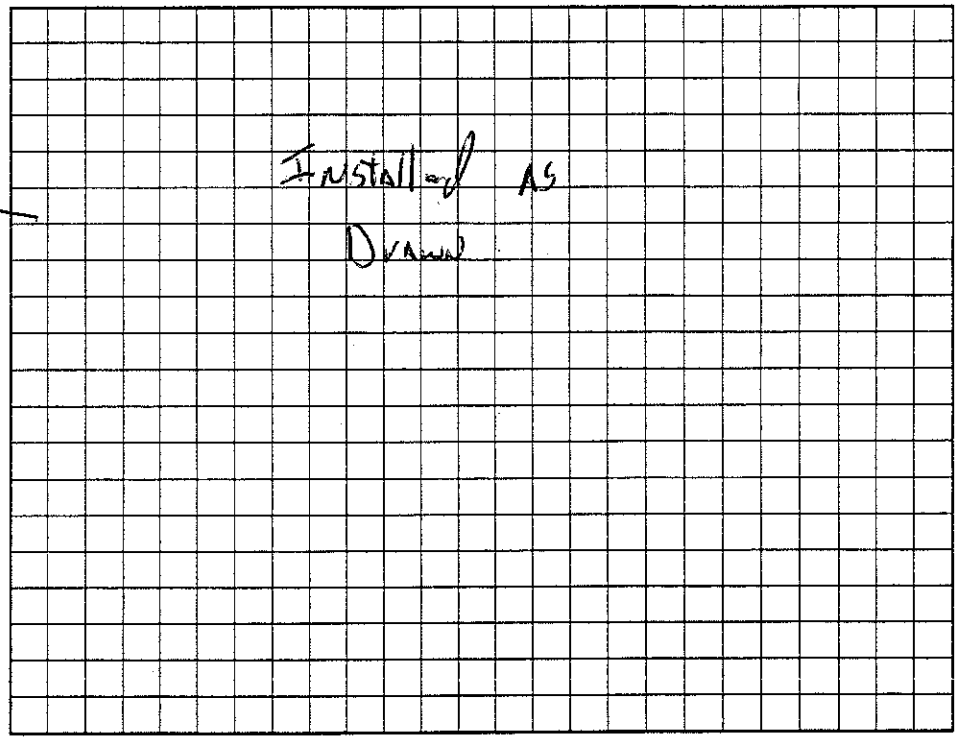

Permit can be suspended or revoked if any false information is supplied toward securing the permit/any unauthorized changes are made to the site/any unauthorized changes are made in the installation of the system. Improvement Permit with plat valid without expiration. Improvement ~~Permit with~~ site plan valid for sixty months. Authorization to Construct is valid for a period equal to that of Improvement Permit – not to exceed sixty months.

Signed: + Mark Hux date 12-21-06 Installed by: Craig Thompson

Improvement Permit by: STEVE HENDRICK date 12-21-06 Operation Permit by: R.S. date 2-15-07

Authorization to Construct by: STEVE HENDRICK date 12-21-06 Existing System Inspection by: _____ date _____

HEALTH DEPT. COPY: WHITE OWNER COPY (FINAL): YELLOW OWNER COPY (INITIAL): PINK