IREDELL COUNTY HEALTH DEPARTMENT

Statesville Phone TR 3-7271 Mooresville Phone NO 3-1271

PERMIT TO INSTALL SEPTIC TANK

Permit NO. 160 Permit Date 3-26 1970

Owner Herman Lloyd Address ?

Installed By Sam Davis Address Rt # 2 Harmony N.C.


Location of Property On Sherwood Forest - 1st House on Right after leaving Hwy 21.

Tank		Capacity		Length of Lines		Fixtures	
Block	( )	1000	( )	225'	( )	No. of Baths	( )
Precast	( )	1250	( )	250'	( )	Dishwasher	( )
		1500	( )	Other		Garbage Grdr.	( )
		Other				Other	

NOTIFY HEALTH DEPARTMENT AT LEAST EIGHT HOURS BEFORE TANK IS TO BE INSPECTED.

Final Inspection 3-26 1970 Approved ( ) Disapproved ( )

Remarks

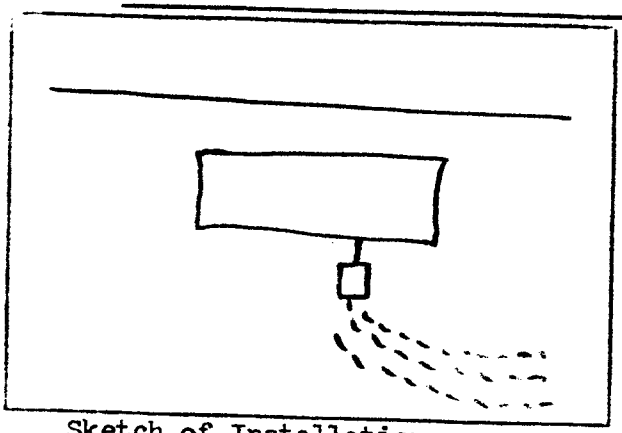

Sketch of Installation

Sanitarian