IREDELL COUNTY HEALTH DEPARTMENT

Statesville Office (704) 878-5305 Mooresville Office (704) 660-3625 PERMIT # 181256 DF

IMPROVEMENT PERMIT / AUTHORIZATION TO CONSTRUCT / OPERATION PERMIT / EXISTING SYSTEM

PIN # 4746540982

APPLICANT: Horne Building Inc. APPLICANT ADDRESS: 229 Cedar Lake Dr.

SITE ADDRESS: 137 Debbie Ln. E PHONE: 704-902-0399 ALT. PHONE: N/A

SITE DIRECTIONS: Hwy 21 N TL Shumaker Rd TR Debbie Ln E.

SUBDIVISION: Iredell Heights SECTION: N/A LOT # 724-728 LOT AREA: 0.51 acres DESIGN FLOW: 360 gpd L.T.A.R.: 0.3

Septic Tank 1000 (gal) STB 760-1000 Date 10-3-13
Pump Tank (gal) PT Date
Pump Make Model Serial #
Nitrification Fields 1 # Lines 4 Linear Ft: 300
Trench Width 36" Max. Trench Bottom Depth 36" Gravel Depth N/A

☑ New System ☐ Repair ☐ Expansion System Type: I II ☑ III IV V VI
System Description: 25% Reduction
Repair System Description: 25% Reduction
Maintenance Agreement Required: ☐ YES ☑ NO
☑ GRAVITY ☐ PRESSURE

☑ Residence No. Bedrooms 3
☐ Business No. Persons 6
☐ Other No. Employees
☑ Slab ☐ Crawl Space
☐ Basement w/plumbing ☐ Basement w/o plumbing


Water Supply: ☐ Private ☑ Public ☐ Community

Comments / Conditions:

INITIAL SITE SKETCH

See attached plan by
Kathleen Saunders, LSS

AS BUILT SKETCH

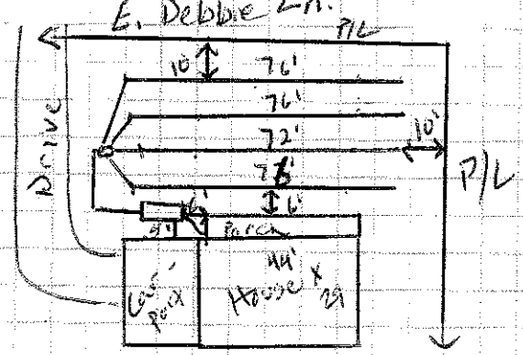

- Quick 4 Chambers installed
- 2" PVC tank marker installed.
- Red Polylok installed

- Installed as drawn here

Scale: 1" = 50'

Permit can be suspended or revoked if any false information is supplied toward securing the permit / any unauthorized changes are made to the site / any unauthorized changes are made in the installation of the system. **CONTACT A LOCATOR SERVICE PRIOR TO ANY EXCAVATION**

☐ **IMPROVEMENT PERMIT** ***with plat*** *valid without expiration.* ☑ **IMPROVEMENT PERMIT** ***with site plan*** *valid for 60 mos.* ☑ **AUTHORIZATION TO CONSTRUCT** *valid for period equal to IMPROVEMENT PERMIT--not to exceed 60 mo.*

Owner / Applicant Signature: Carolyn B Horne Date: 11-5-13 Installed by: Catheran & Son Grading

IMPROVEMENT PERMIT by: Justin Henderson Date: 10-22-13 OPERATION PERMIT by: Justin Henderson Date: 2-27-14

AUTHORIZATION TO CONSTRUCT by: Justin Henderson Date: 10-22-13 Existing System Inspected by: Date:

Health Dept. Copy - WHITE Applicant (Final Approval) - YELLOW Applicant (Conditional Approval) - PINK