IREDELL COUNTY HEALTH DEPARTMENT

Statesville Phone TR 3-7271 Mooresville Phone NO 3-1271

PERMIT TO INSTALL SEPTIC TANK

Permit NO. Mid Way Bldg. Co. Permit Date Aug. 5 1960

Owner Charles Lackey Address Sherwood Forest

Installed By C. Hake Address Rte. 7 City


Location of Property right on dirt at Statesville upholstering Co. 1st on left. in Sherwood dely

Tank		Capacity		Length of Lines		Fixtures	
Block	( )	800	( )	150'	( )	No. of Baths	( )
Precast	(✓)	900	( )	175'	( )	Dishwasher	( )
		1000	(✓)	200'	( )	Garbage Grdr.	( )
		1100	( )	225'	(✓)	Auto-Washer	( )
		1200	( )	250'	( )	Other	
		Other		Other			

NOTIFY HEALTH DEPARTMENT AT LEAST EIGHT HOURS BEFORE TANK IS TO BE INSPECTED.

Final Inspection Aug 5 1960 Approved ( ) Disapprcved ( )

Remarks Well 100'. Layout checked by R. Thomas Sanitarian and Boggette from Raleigh

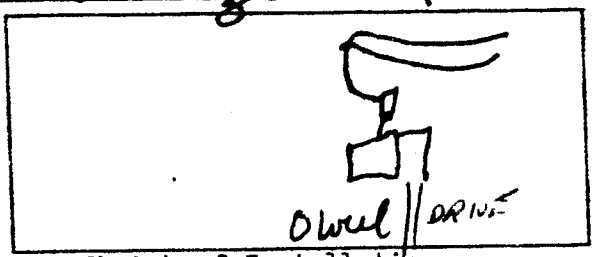

Sketch of Installation

R. A. Self Sanitarian