IREDELL COUNTY HEALTH DEPARTMENT - *ENVIRONMENTAL HEALTH* ☒ STATESVILLE OFFICE 704-878-5305 ☐ MOORESVILLE OFFICE 704-664-5281

IMPROVEMENT PERMIT / AUTHORIZATION TO CONSTRUCT (1) / OPERATION PERMIT (1) / EXISTING SYSTEM INSPECTION

PERMIT # 162913 PIN # 4746552101 DATE 9-22-10

OWNER Wesley Community Development APPLICANT: PHONE: Home/Cell # 704 924 8942 Business # 704 902 5603

SITE ADDRESS 127 E. Debbie Lane OWNER / APPLICANT ADDRESS 1321-C Dixie Drive Statesville, NC 28677

SITE DIRECTIONS 21(N) (L) onto Shumaker Dr; (R) onto E Edison Dr; (R) onto E. Debbie Ln; lot on left corner

SUBDIVISION Iredell Heights BLOCK / SECTION LOT # 733-737 LOT AREA 125x172 DESIGN FLOW 360 L.T.A.R. .3


Septic Tank 1000	Gallons: STB 160	Date 7-26-10	☒ New System	☐ Repair	☐ Expansion System	Type I II (III) IV V VI	☒ Residence
Pump Tank	Gallons: P T	Date	System Description: 25% Reduction Gravity				☐ Business
Pump Make	Model	Serial #	Repair System Description: 25% Reduction Gravity				☐ Other
No. Nitrification Fields: 1	No. Lines 3	Linear Feet 300	Maintenance Agreement Required	☐ YES	☒ NO		☐ Slab
Trench Width 36"	Max. Trench Bottom Depth 36"	Gravel Depth n/a	☒ GRAVITY	☐ PRESSURE			☐ Basement w/plumbing

☒ Residence	No. Bedrooms	3	Water Supply
☐ Business	No. Persons		☐ Private
☐ Other	No. Employees		☒ Public
☐ Slab	☒ Crawl Space		☐ Community
☐ Basement w/plumbing	☐ Basement w/o plumbing		

Comments / Conditions

End cap distribution
10-4W

INITIAL SITE SKETCH

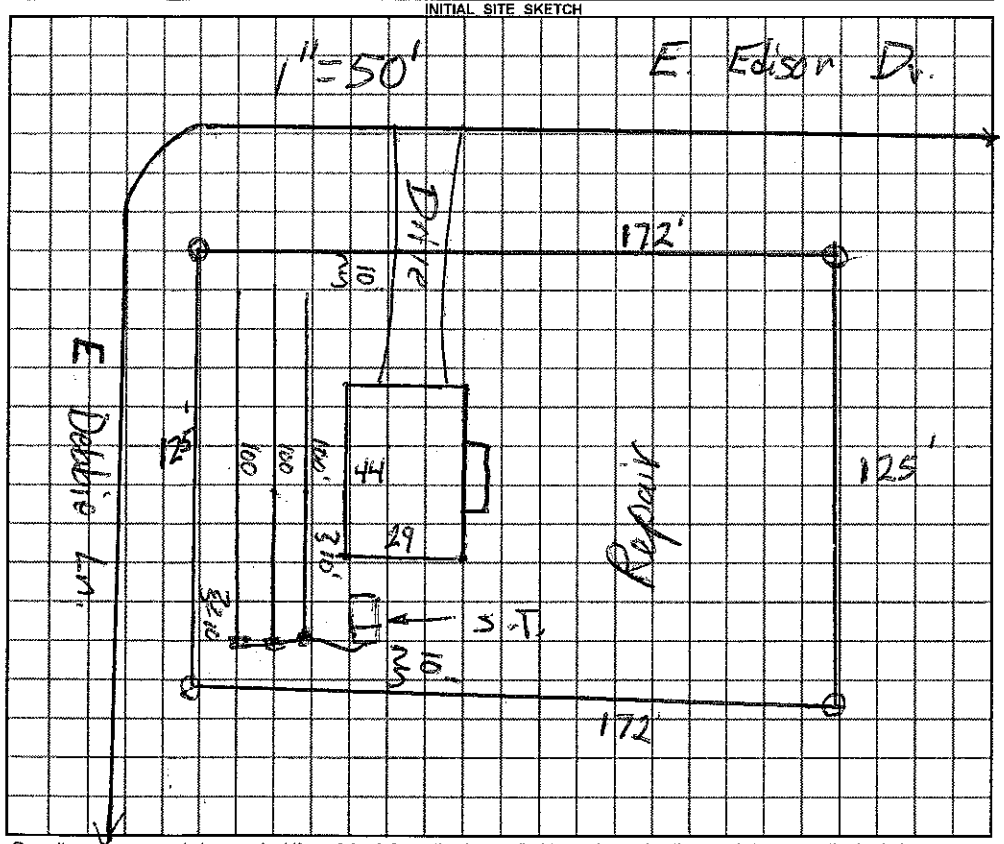

AS BUILT SKETCH

Permit can be suspended or revoked if any false information is supplied toward securing the permit / any unauthorized changes are made to the site / any unauthorized changes are made in the installation of the system.

☒ ***IMPROVEMENT PERMIT*** with plat valid without expiration ☒ ***IMPROVEMENT PERMIT*** with plat valid without expiration. ☒ ***AUTHORIZATION TO CONSTRUCT*** valid for period equal to IMPROVEMENT PERMIT--not to exceed 60 mo.

Owner / Applicant Signature: Wayne Ward Date 9-23-10 Installed by: Tommy Cothren

IMPROVEMENT PERMIT by: REHS Date 9-22-10 OPERATION PERMIT by: REHS Date 11-8-10

AUTHORIZATION TO CONSTRUCT by: REHS Date 9-22-10 Existing System Inspected by: REHS Date

YOU SHOULD CONTACT A LOCATOR SERVICE PRIOR TO ANY EXCAVATION

White Copy – Environmental Health YELLOW COPY (Final) Owner / Applicant PINK COPY (Initial) Owner / Applicant