IREDELL COUNTY HEALTH DEPARTMENT

Statesville Office (704) 878-5305 Mooresville Office (704) 660-3625 PERMIT # 179944

IMPROVEMENT PERMIT / AUTHORIZATION TO CONSTRUCT / OPERATION PERMIT / EXISTING SYSTEM

PIN # 4746555904

APPLICANT: Roy Smith APPLICANT ADDRESS: 681 Turnersburg Hwy

SITE ADDRESS: 681 Turnersburg Hwy PHONE: 704-253-3614 ALT. PHONE: N/A

SITE DIRECTIONS: Hwy 21 N Property on left just before Fairview Mobile Home Park


SUBDIVISION: N/A SECTION: N/A LOT # N/A LOT AREA: 2.5 acres DESIGN FLOW: 360gpd L.T.A.R.: 0.3

Septic Tank	1000 (gal)	STB	1012-1000	Date	11-9-12	☐ New System	☑ Repair	☐ Expansion	System Type: I II III IV V VI
Pump Tank	(gal)	PT		Date		System Description:			
Pump Make		Model		Serial #		Repair System Description:	25% Reduction		
# Nitrification Fields	1	# Lines	5	Linear Ft:	250	Maintenance Agreement Required:	☐ YES	☑ NO	
Trench Width	36"	Max. Trench Bottom Depth	36"	Gravel Depth	N/A		☑ GRAVITY	☐ PRESSURE	

☑ Residence	No. Bedrooms	3	Water Supply
☐ Business	No. Persons		☑ Private
☐ Other	No. Employees		☐ Public
☐ Slab	☑ Crawl Space		☐ Community
☐ Basement w/plumbing		☐ Basement w/o plumbing	

Comments / Conditions: Install a 25% Reduction system on contour with serial distribution. Pump & crush existing septic tank. Place new 1000 gallon septic tank at location shown below.

INITIAL SITE SKETCH

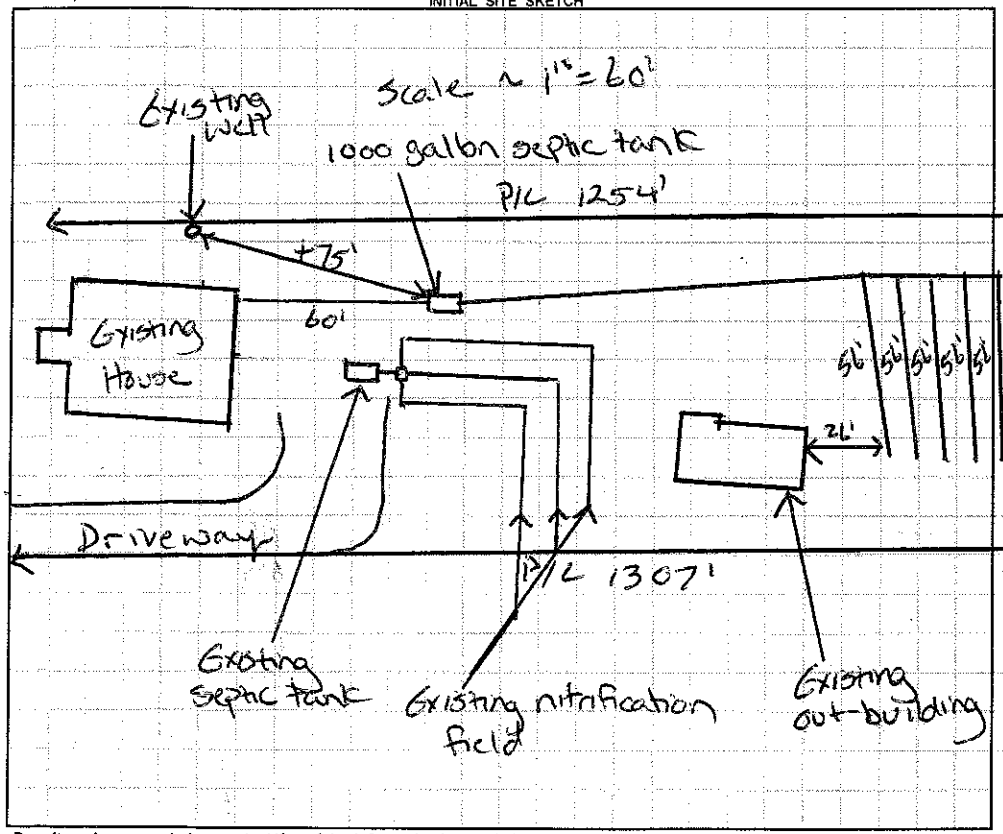

AS BUILT SKETCH

- Red Poly/lot filter installed
- 2" PVC septic tank marker installed
- Quick 4 chambers installed
- Installed as drawn

Permit can be suspended or revoked if any false information is supplied toward securing the permit / any unauthorized changes are made to the site / any unauthorized changes are made in the installation of the system. **CONTACT A LOCATOR SERVICE PRIOR TO ANY EXCAVATION**

☐ **IMPROVEMENT PERMIT** *with plat valid without expiration.* ☑ **IMPROVEMENT PERMIT** *with site plan valid for 60 mos.* ☑ **AUTHORIZATION TO CONSTRUCT** *valid for period equal to IMPROVEMENT PERMIT--not to exceed 60 mo.*

Owner / Applicant Signature: Roy Smith Date: 10-1-13 Installed by: David Yountz

IMPROVEMENT PERMIT by: Justin Henderson Date: 9-25-13 OPERATION PERMIT by: Justin Henderson Date: 10-18-13

AUTHORIZATION TO CONSTRUCT by: Justin Henderson Date: 9-25-13 Existing System Inspected by: Date:

Health Dept. Copy - WHITE Applicant (Final Approval) - YELLOW Applicant (Conditional Approval) - PINK