IREDELL COUNTY HEALTH DEPARTMENT

Statesville Phone TR 3-7271 Mooresville Phone NO 3-1271

PERMIT TO INSTALL SEPTIC TANK

Permit NO. 284 Permit Date Aug. 25 1970

Owner CARL Bush Address STATESVILLE, N.C.

Installed By YORK Rufty Address Stony Point, N.C.


Location of Property NORTH on HIGHWAY 21. 4TH HOUSE on LEFT Beyond Road #1955. IREDELL HEIGHTS

Tank		Capacity		Length of Lines		Fixtures	
Block	( )	1000	(✓)	225'	(✓)	No. of Baths	( )
Precast	(✓)	1250	( )	250'	( )	Dishwasher	( )
		1500	( )	Other		Garbage Grdr.	( )
		Other				Other	

NOTIFY HEALTH DEPARTMENT AT LEAST EIGHT HOURS BEFORE TANK IS TO BE INSPECTED.

Final Inspection AUG 25 1970 Approved (✓) Disapproved ( )

Remarks (IREDELL WATER CORP. water Supply

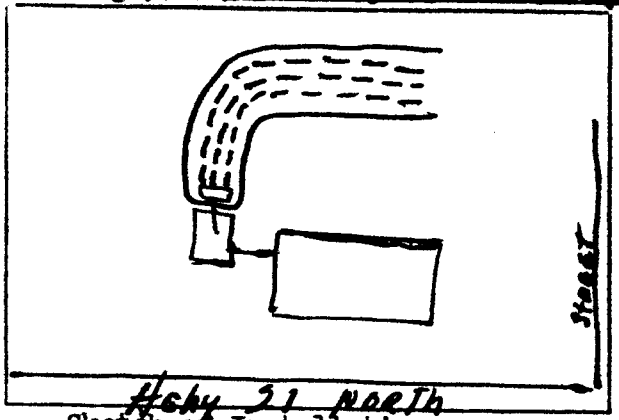

Sketch of Installation

Glenn Todd Jr.

Sanitarian