IREDELL COUNTY HEALTH DEPARTMENT

STATESVILLE 704-878-5305 MOORESVILLE 704-664-5281

IMPROVEMENT PERMIT / AUTHORIZATION TO CONSTRUCT / OPERATION PERMIT / EXISTING SYSTEM INSPECTION @

PERMIT# 16580i PIN# 4746-56-4792 DATE 4-8-11

OWNER OR APPLICANT Johnny L. (Dale) Fox PHONE: Business 704-902-0391 Home

ADDRESS 129 Houpe Rd

LOCATION 21 N (L) on Houpe Rd; 3rd house on left

SUBDIVISION n/a BLOCK / SECTION n/a LOT n/a LOT AREA 5.572 SITE CLASS. PS DESIGN FLOW Ex L.T.A.R. Ex

Septic Tank: Ex Gallons: STB Date

Pump Tank: Gallons: PT Date

Pump Make: Model Serial No.

Nitrification Field: No Fields Square Feet Linear Feet

No Lines Trench Width Max Trench Bottom Depth Gravel Depth ☐ Gravity ☐ Pressure

☐ New System ☐ Repair ☐ Expansion System Type: I II III IV V VI

System Description:

Repair System Description:

Maintenance Agreement Required: ☐ Yes ☐ No

☐ House/Mod. Home ☐ Mobile Home ☐ Business ☐ Other

No. Bedrooms No. Persons No. Employees

Water Supply: ☐ Individual ☐ Public ☐ Community


☐ Slab ☐ Crawl Space ☐ Basement w/plumbing ☐ Basement wo/plumbing

Comments/Conditions: Adding ~~Space~~ to expand Kitchen - no actual rooms are being created.

INITIAL SITE SKETCH

~~Comments/Conditions:~~ 1003'

AS BUILT SKETCH

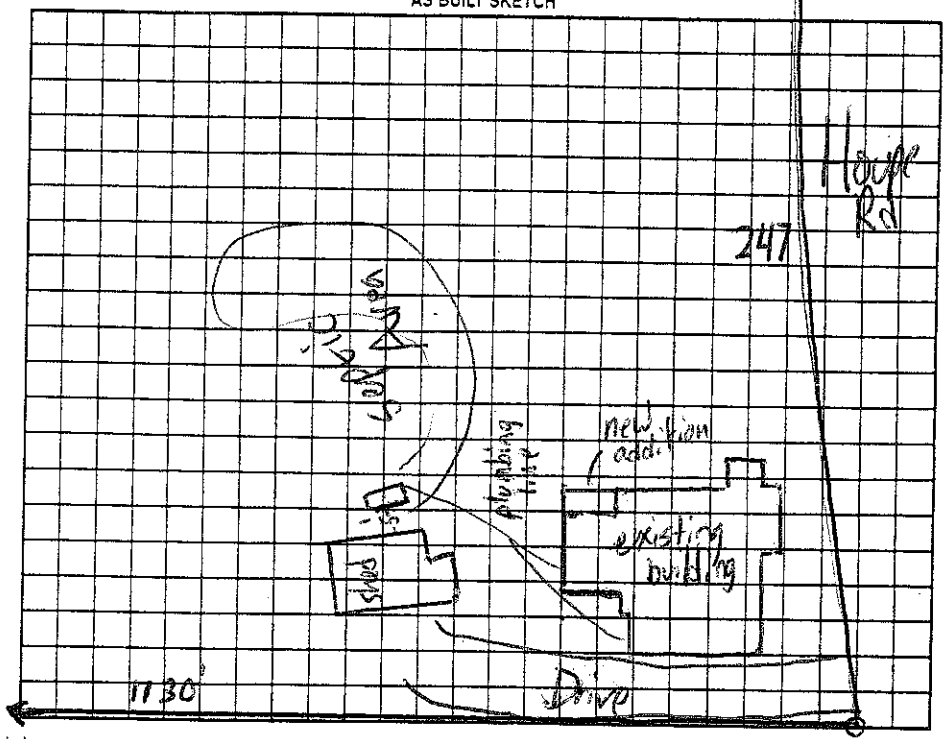

Permit can be suspended or revoked if any false information is supplied toward securing the permit/any unauthorized changes are made to the site/any unauthorized changes are made in the installation of the system. Improvement Permit with plat valid without expiration ☐ Improvement Permit with site plan valid for sixty months ☐ Authorization to Construct is valid for a period equal to that of Improvement Permit – not to exceed sixty months.

Signed: Johnny L Fox date 4-8-11

Improvement Permit by: date

Authorization to Construct by: date

Installed by:

Operation Permit by: date

Existing System Inspection by: date

HEALTH DEPT. COPY: WHITE OWNER COPY (FINAL): YELLOW OWNER COPY (INITIAL): PINK