IREDELL COUNTY HEALTH DEPARTMENT

STATESVILLE 704-878-5305 MOORESVILLE 704-664-5281

IMPROVEMENT PERMIT / AUTHORIZATION TO CONSTRUCT / OPERATION PERMIT / EXISTING SYSTEM INSPECTION

PERMIT# 79752 PIN# 4746524584 DATE 3-25-99

OWNER OR CONTRACTOR Don Allen Barker Jr. PHONE: Business _____ Home 876-3513

ADDRESS 104 Houpe Rd Statesville, N.C.

LOCATION 21 N to Houpe Rd 1/4 mi Rt

SUBDIVISION _____ BLOCK / SECTION _____ LOT ~~Lot~~ AREA 1.0 acre SITE CLASS PS DESIGN FLOW 360 L.T.A.R. .35

Septic Tank: 1000 Gallons; STB 1012 Date 2-30-99

Pump Tank: _____ Gallons; PT _____ Date _____

Pump Make: _____ Model _____ Serial No _____

Nitrification Field: No Fields 1 Square Feet 780 Linear Feet 260

No Lines 3 Trench Width 36" Max Trench Bottom Depth 36" Gravel Depth N/A

☐ New System ☐ Repair System Type: I. II. III. IV. V. VI

System Description: Gravity 25% Red

Repair System Description: Gravity Panels

Maintenance Agreement Required: ☐ Yes ☑ No

☑ House/Mod. Home No. Bedrooms 3

☐ Mobile Home No. Bathrooms 2

☐ Business No. Employees _____


☐ Other _____

☐ Slab ☑ Crawl Space ☐ Basement w/plumbing ☐ Basement wo/plumbing

Water Supply: ☐ Individual ☑ Public ☐ Community


Comments/Conditions:

INITIAL SITE SKETCH

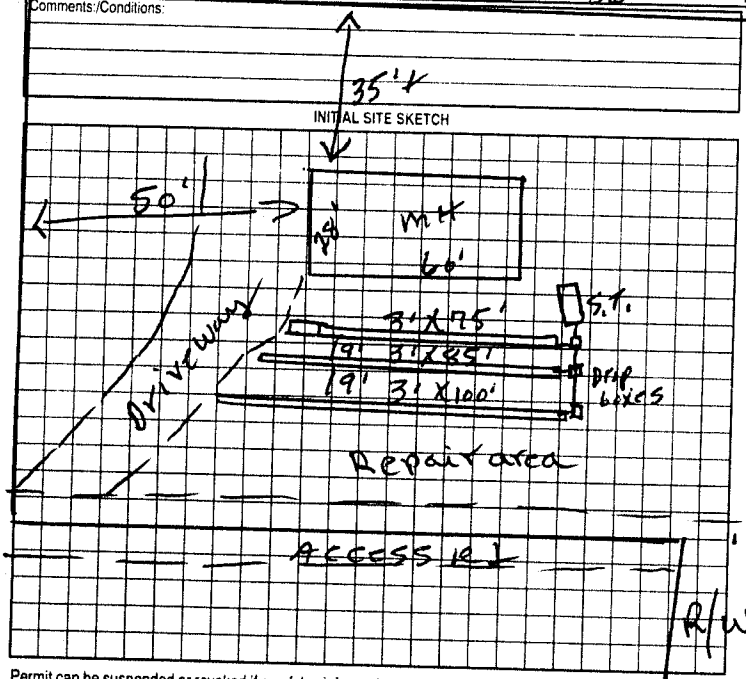

Comments/Conditions:

AS BUILT SKETCH

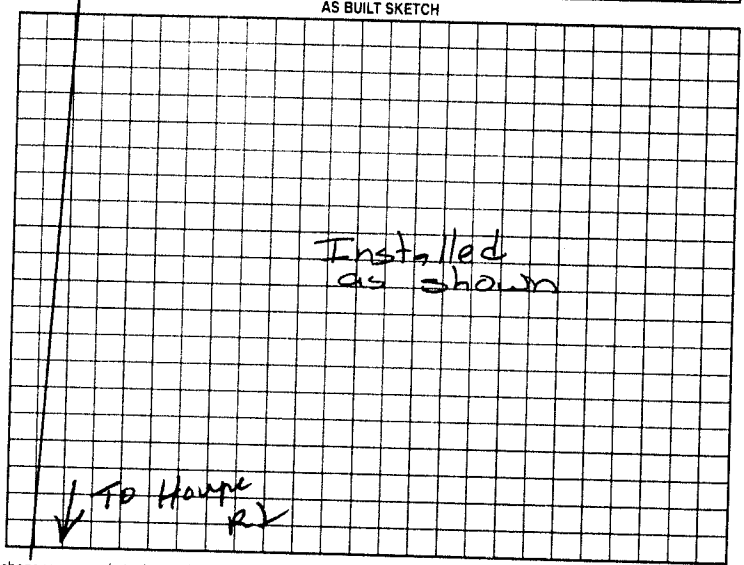

Permit can be suspended or revoked if any false information is supplied toward securing the permit/any unauthorized changes are made to the site/any unauthorized changes are made in the installation of the system. Improvement Permit with plat valid without expiration. Improvement Permit with site plan valid for sixty months. Authorization to Construct is valid for a period equal to that of Improvement Permit – not to exceed sixty months.

Signed: Don A. Barker Jr. date 3-26-99 Installed by: A-1 Backhoe

Improvement Permit by: F. C. Moore date 3-25-99 Operation Permit by: Mary C Cox RS date 4-22-99

Authorization to Construct by: F. C. Moore date 3-25-99 Existing System Inspection by: _____ date _____

HEALTH DEPT COPY WHITE OWNER COPY (FINAL) YELLOW OWNER COPY (INITIAL) PINK