IREDELL COUNTY HEALTH DEPARTMENT

STATESVILLE 704-878-5305 MOORESVILLE 704-664-5281

IMPROVEMENT PERMIT / AUTHORIZATION TO CONSTRUCT / OPERATION PERMIT / EXISTING SYSTEM INSPECTION

PERMIT# REPAIR PIN# 4746-62-2665 DATE 4-30-07

OWNER OR CONTRACTOR TIMOTHY LEE WARD PHONE: Business Home 704-252-4095

ADDRESS 156 LITTLE JOHN ROAD STATESVILLE, NC 28625

LOCATION US 21 N, TR JANE SOWERS ROAD, TR LITTLE JOHN ROAD, HOUSE ON RIGHT AT #156

SUBDIVISION SHERWOOD FOREST BLOCK / SECTION LOT 8 LOT AREA LIMITED SITE CLASS. PS DESIGN FLOW 360 L.T.A.R. 0.30 GPD/FT2

Septic Tank: EXISTING Gallons; ST8 Date

Pump Tank: Gallons; PT Date

Pump Make: Model Serial No.

Nitrification Field: No Fields 1 Square Feet EQ TO 768 Linear Feet 192

No Lines TWO Trench Width 36" Max Trench Bottom Depth 36" Gravel Depth N/A

☐ New System ☑ Repair System Type: I (II) III, IV, V, VI

System Description:

Repair System Description: 25% REDUCTION, GRAVITY

Maintenance Agreement Required: ☐ Yes ☑ No

☑ House/Mod. Home No. Bedrooms 3

☐ Mobile Home No. Bathrooms

☐ Business No. Employees

☐ Other


☐ Slab ☑ Crawl Space ☐ Basement w/plumbing ☐ Basement wo/plumbing

Water Supply: ☐ Individual ☑ Public ☐ Community

Comments:/Conditions: ① REPLACE SANITARY TEE IN SEPTIC TANK ② INSTALL NEW DISTRIBUTION BOX AS SHOWN ③ INSTALL TWO NEW DRAINLINES ON CONTOUR AS FLAGGED USING 25% REDUCTION.

Comments:/Conditions:

INITIAL SITE SKETCH

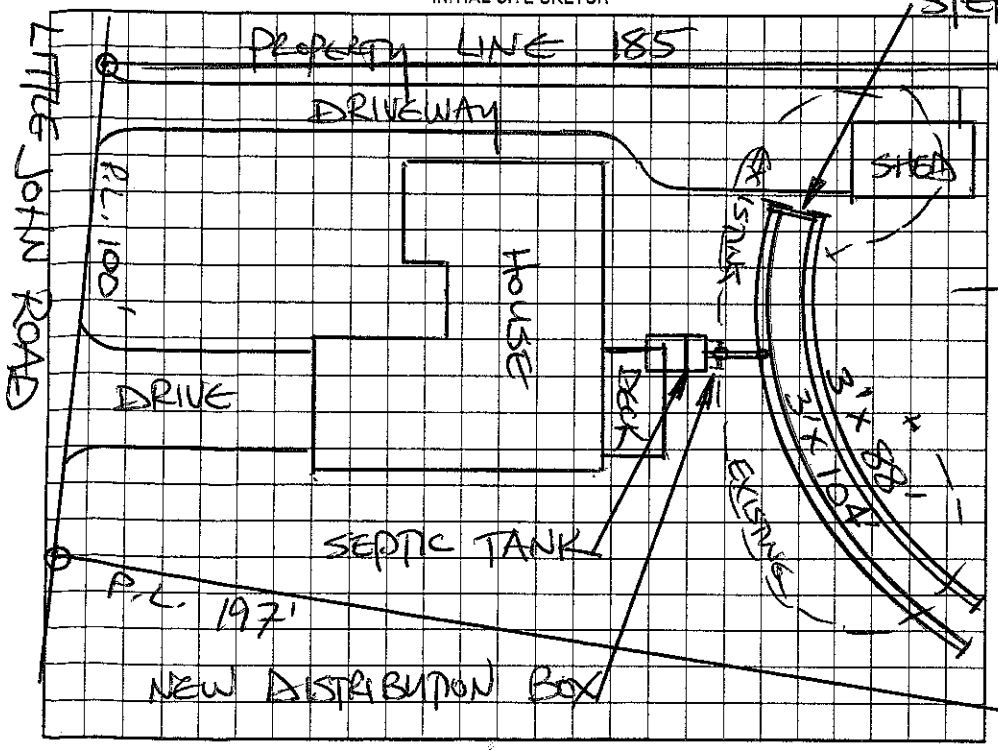

AS BUILT SKETCH

SYSTEM INSTALLED ACCORDING TO INITIAL SITE SKETCH

Permit can be suspended or revoked if any false information is supplied toward securing the permit/any unauthorized changes are made to the site/any unauthorized changes are made in the installation of the system. Improvement Permit with plat valid without expiration. Improvement Permit with site plan valid for sixty months. Authorization to Construct is valid for a period equal to that of Improvement Permit – not to exceed sixty months.

Signed: [signature] date 4-30-07 Installed by: C & J BACKHOE

Improvement Permit by: STEVE HEDRICK date 4-30-07 Operation Permit by: STEVE HEDRICK date 5-1-07

Authorization to Construct by: STEVE HEDRICK date 4-30-07 Existing System Inspection by: date

HEALTH DEPT. COPY: WHITE OWNER COPY (FINAL): YELLOW OWNER COPY (INITIAL): PINK