IREDELL COUNTY HEALTH DEPARTMENT

STATESVILLE 704-878-5305 (C1) MOORESVILLE 704-664-5281

IMPROVEMENT PERMIT / AUTHORIZATION TO CONSTRUCT / OPERATION PERMIT / EXISTING SYSTEM INSPECTION

PERMIT# 125662 PIN# 4746-62-8672 DATE 1-6-05

OWNER OR CONTRACTOR WILLIAM P. & JANICE McALPIN PHONE: Business 704-902-2109 Home 704-876-4928

ADDRESS 614 JENNINGS ROAD STATESVILLE NC 28625-9506

LOCATION US 21 N TR JANE SOWERS RD, TR FRIAR TUCK ROAD TL MARIAN LANE, LOT #13 AT END ON CUL-DE-SAC

SUBDIVISION SHERWOOD FOREST BLOCK / SECTION IV LOT 13 LOT AREA 0.594 ACRE SITE CLASS. PS DESIGN FLOW 360 L.T.A.R. 0.30 GPD/FT2

Septic Tank: 1000 Gallons; STB 1007 Date 4-4-05
Pump Tank: ____ Gallons; PT ____ Date ____
Pump Make: ____ Model ____ Serial No. ____
Nitrification Field: No Fields 1 Square Feet 1200 Linear Feet 400
No Lines FIVE Trench Width 36" Max Trench Bottom Depth 48" Gravel Depth 12"

☒ New System ☐ Repair System Type: I, (II), III, IV, V, VI
System Description: CONVENTIONAL GRAVITY
Repair System Description: 50% REDUCTION, LOW PRESSURE
Maintenance Agreement Required: ☐ Yes ☒ No

☒ House/Mod. Home No. Bedrooms 3
☐ Mobile Home No. Bathrooms ____
☐ Business No. Employees ____
☐ Other ____


☐ Slab ☑ Crawl Space ☐ Basement w/plumbing ☐ Basement wo/plumbing

Water Supply: ☐ Individual ☒ Public ☐ Community

Comments:/Conditions: (C1) INSTALL LINES AS FLAGGED ON SITE, (15A NCAC 18A .1955 (9)) (LESS THAN 2% SLOPE)
(2) KEEP SYSTEM MINIMUM TEN (10) FEET FROM PROPERTY LINE, TEN (10) FEET FROM WATER SERVICE

Comments:/Conditions: SEPTIC TANK WITH MARKER INSTALLED
USING "ZABEL" FILTER
NO FILL DIRT ALLOWED OVER DRAINFIELD

INITIAL SITE SKETCH

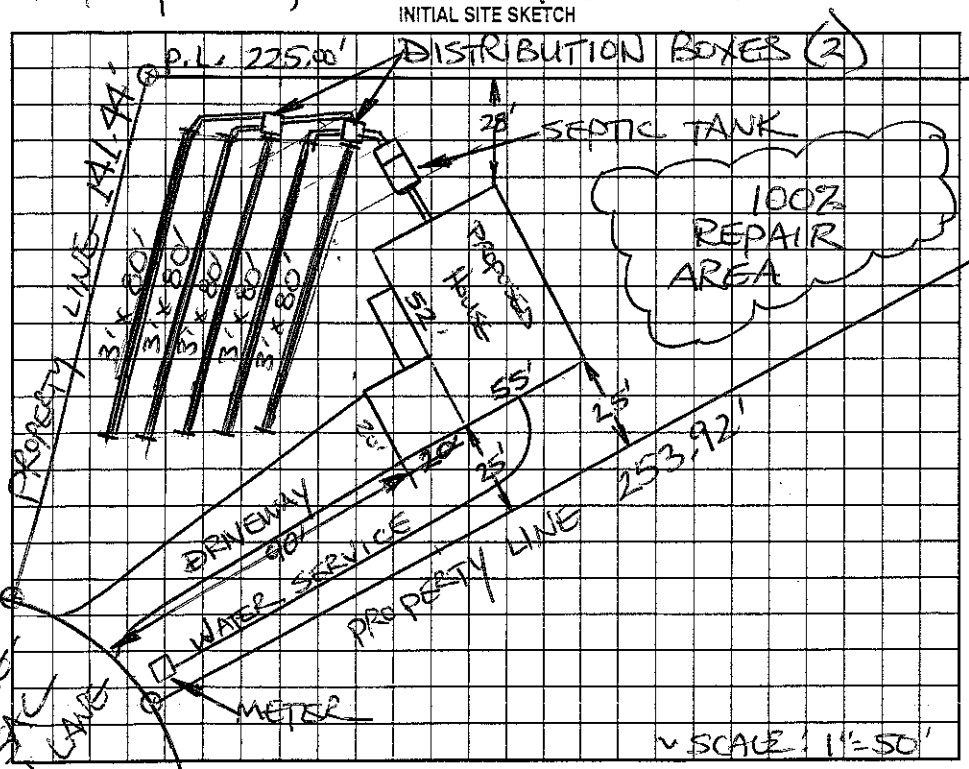

AS BUILT SKETCH

SYSTEM INSTALLED ACCORDING TO INITIAL SITE SKETCH

Permit can be suspended or revoked if any false information is supplied toward securing the permit/any unauthorized changes are made to the site/any unauthorized changes are made in the installation of the system. Improvement Permit with plat valid without expiration. Improvement Permit with site plan valid for sixty months. Authorization to Construct is valid for a period equal to that of Improvement Permit – not to exceed sixty months.

Signed: Jan McAlpin date 1-7-05 Installed by: K & M GRADING

Improvement Permit by: STEVE HEDRICK date 1-6-05 Operation Permit by: STEVE HEDRICK date 5-18-05

Authorization to Construct by: STEVE HEDRICK date 1-6-05 Existing System Inspection by: ____ date ____

HEALTH DEPT. COPY: WHITE OWNER COPY (FINAL): YELLOW OWNER COPY (INITIAL): PINK