IREDELL COUNTY HEALTH DEPARTMENT

Statesville Office (704) 878-5305 Mooresville Office (704) 660-3625 PERMIT # 202425

IMPROVEMENT PERMIT / AUTHORIZATION TO CONSTRUCT / OPERATION PERMIT / EXISTING SYSTEM

PIN # 4746628826

APPLICANT: William Eggett APPLICANT ADDRESS: 112 Marian Ln.

SITE ADDRESS: 112 Marian Ln. - Statesville PHONE: 704-778-7120 ALT. PHONE: N/A


SITE DIRECTIONS: Hwy 21 N TR Jane Sawess Rd TR Friar Tuck TL Marian Ln.

SUBDIVISION: Sherwood Forest SECTION: 3 LOT # 10 LOT AREA: 0.55 acres DESIGN FLOW: 360gpd L.T.A.R.: Existing

Septic Tank	~~1000~~ EX (gal)	STB	Date	☐ New System ☑ Repair ☐ Expansion System Type: I ☑ II III IV V VI	☑ Residence	No. Bedrooms 3	Water Supply
Pump Tank	(gal)	PT	Date	System Description:	☐ Business	No. Persons 2	☐ Private
Pump Make	Model		Serial #	Repair System Description: TANK	☐ Other	No. Employees	☑ Public
# Nitrification Fields 1	# Lines 5		Linear Ft: EX	Maintenance Agreement Required: ☐ YES ☑ NO	☐ Slab	☑ Crawl Space	☐ Community
Trench Width EX	Max. Trench Bottom Depth EX		Gravel Depth EX	☑ GRAVITY ☐ PRESSURE	☐ Basement w/plumbing	☐ Basement w/o plumbing	

Comments / Conditions: Pump & crush existing septic tank. Set new tank @ location shown below & connect to existing drainfield.

INITIAL SITE SKETCH

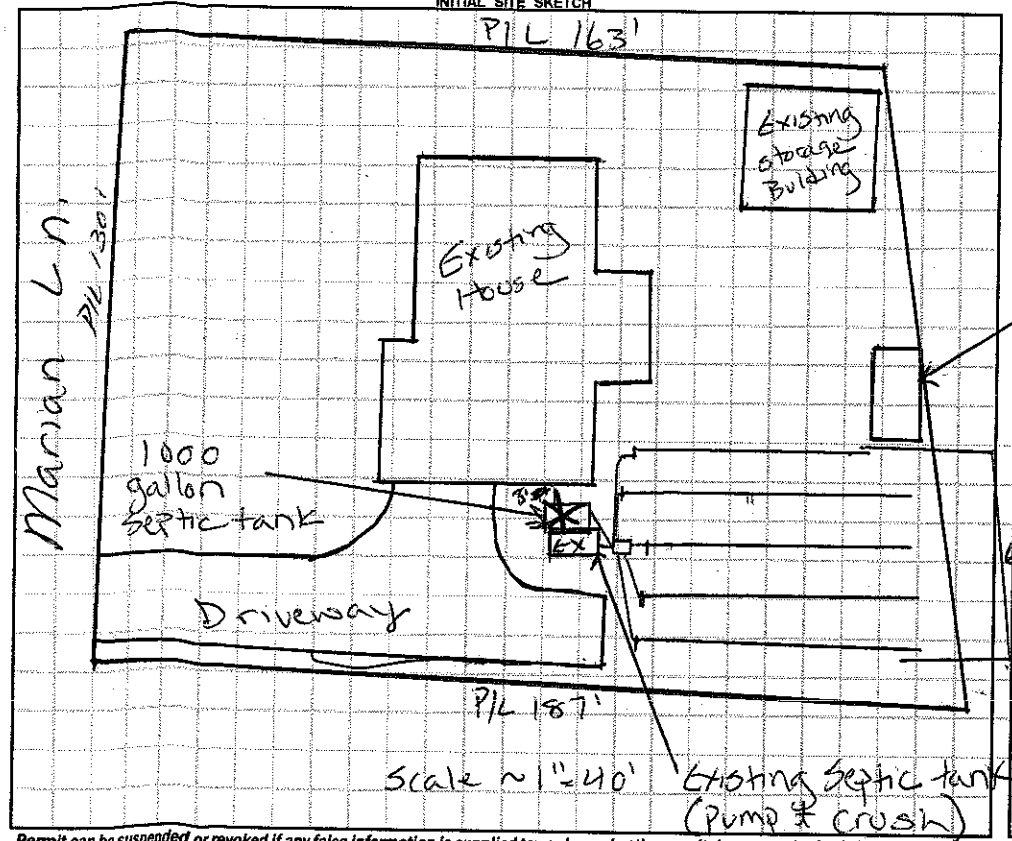

AS BUILT SKETCH

- New tank set on top of existing septic tank, sealed w/ tar type lid.
- Risers installed on new tank
- New PVC tee installed

Permit can be suspended or revoked if any false information is supplied toward securing the permit / any unauthorized changes are made to the site / any unauthorized changes are made in the installation of the system. **CONTACT A LOCATOR SERVICE PRIOR TO ANY EXCAVATION**

☐ **IMPROVEMENT PERMIT** *with plat valid without expiration.* ☑ **IMPROVEMENT PERMIT** *with site plan valid for 60 mos.* ☑ **AUTHORIZATION TO CONSTRUCT** *valid for period equal to IMPROVEMENT PERMIT--not to exceed 60 mo.*

Owner / Applicant Signature: William Eggett Date:

IMPROVEMENT PERMIT by: Justin O Henderson Date: 4-10-14

AUTHORIZATION TO CONSTRUCT by: Justin O Henderson Date: 4-10-14

Installed by: K & M Grading

OPERATION PERMIT by: Justin Henderson Date: 5-19-14

Existing System Inspected by: Date:

Health Dept. Copy - WHITE Applicant (Final Approval) - YELLOW Applicant (Conditional Approval) - PINK