IREDELL COUNTY HEALTH DEPARTMENT

Statesville Phone TR 3-7271 Mooresville Phone NO 3-1271

PERMIT TO INSTALL SEPTIC TANK

Permit NO. 46 Permit Date 8-7 1972

Owner REV. J.C. GAMALTNEY Address STATESVILLE, N.C.

Installed By YORK RUFTY Address STONY POINT, N.C.


Location of Property 21 N - TURN RIGHT AT STA. UPHOLSTERING CO. ON RD # 2171 - 2ND HOUSE ON RIGHT

Tank		Capacity		Length of Lines		Fixtures	
Block	( )	1000	( )	225'	( )	No. of Baths	( )
Precast	(✓)	1250	(✓)	250'	( )	Dishwasher	(✓)
		1500	( )	Other 270		Garbage Grdr.	(✓)
		Other				Other	

NOTIFY HEALTH DEPARTMENT AT LEAST EIGHT HOURS BEFORE TANK IS TO BE INSPECTED.

Final Inspection 8-7 1972 Approved (✓) Disapproved ( )

Remarks IREDELL WATER CORP.

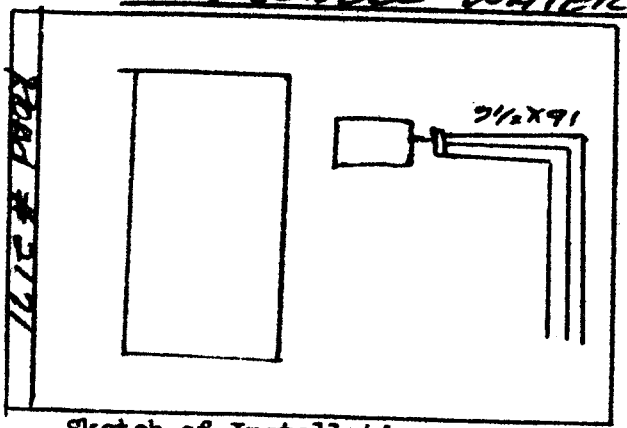

Sketch of Installation

Glenn Fox

Sanitarian