IREDELL COUNTY HEALTH DEPARTMENT

Statesville Phone TR 3-7271 Mooresville Phone NO 3-1271

PERMIT TO INSTALL SEPTIC TANK

Permit NO. _____ Permit Date Jan 17 19 63

Owner Mrs. Bobbie Martin Address Statesville

Installed By Roy Long Address Statesville


Location of Property 4 Oak house on Left in Linwood Forest off Jay 21

Tank	Capacity		Length of Lines		Fixtures	
Block ( )	800	( )	150'	( )	No. of Bath	( )
Precast ( )	900	( )	175'	( )	Dishwasher	( )
Cast	1000	(✓)	200'	( )	Garbage Grdr.	( )
	1100	( )	225'	(✓)	Auto-Washer	( )
	1200	( )	250'	( )	Other	( )
	Other _____		Other _____			

NOTIFY HEALTH DEPARTMENT AT LEAST EIGHT HOURS BEFORE TANK IS TO BE INSPECTED.

Final Inspection Cancelled 19 63 Approved (✓) Disapproved ( )

Remarks To Fix

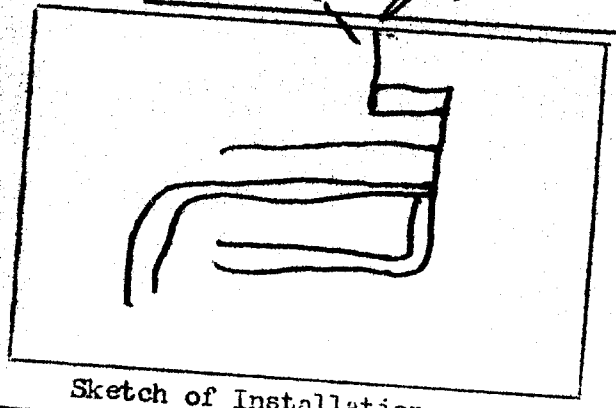

Sketch of Installation

Sanitarian