IREDELL COUNTY HEALTH DEPARTMENT

STATESVILLE 704-878-5305 MOORESVILLE 704-664-5281

IMPROVEMENT PERMIT / AUTHORIZATION TO CONSTRUCT / OPERATION PERMIT / EXISTING SYSTEM INSPECTION

PERMIT# Repair PIN# 4746-63-3882 DATE 8/14/02

OWNER OR CONTRACTOR Michael J. Moore PHONE: Business - Home (704) 876-4262

ADDRESS 116 Robin Loop Loop Statesville N.C. 28625

LOCATION Hwy 21 N. (R) on Jane Sowers Rd. (L) on Robinhood Loop (1st house on Right (Brown Tri-level)

SUBDIVISION Sherwood Forest BLOCK / SECTION — LOT 31 LOT AREA — SITE CLASS. P5 DESIGN FLOW 480 L.T.A.R. .30 gpd/ft²

Septic Tank: 1000 Gallons: STB 920 Date 8-24-02 ☐ New System ☒ Repair System Type: I, II, (III), IV, V, VI

Pump Tank: 1000 Gallons: PT ~~750~~ 144 Date 9-11-02 System Description: Pump, PRESS

Pump Make: Goulds Model WE03111M Serial No. F0263319 Repair System Description: Pump, 50% Reduction

Nitrification Field: No Fields 1 Square Feet 1200 Linear Feet 200 Maintenance Agreement Required: ☐ Yes ☑ No

No Lines 5@40 Trench Width 24" Max Trench Bottom Depth 36" Gravel Depth NA

☒ House/Mod. Home ☐ Mobile Home ☐ Business ☐ Other

No. Bedrooms 4 No. Bathrooms 2½ No. Employees —


☐ Slab ☐ Crawl Space ☒ Basement w/plumbing ☐ Basement wo/plumbing

Water Supply: ☐ Individual ☒ Public ☐ Community


Comments:/Conditions: (1) Septic Tank + Pump Tank must be "Special" reenforced Tanks (2) Use 46 Feet of 33 Feet of Sand (3) reroute H&O line, keep 10 ft from Structure (4) See Attachment "A" & "B"

Comments:/Conditions: TANKS AND UPPER THREE LINES INSPECTED 10-3-02 (RSH) LOWER TWO LINES INSPECTED 10-7-02 - Electrical, Alarm + Pressure Check - Okay

INITIAL SITE SKETCH (Not to Scale)

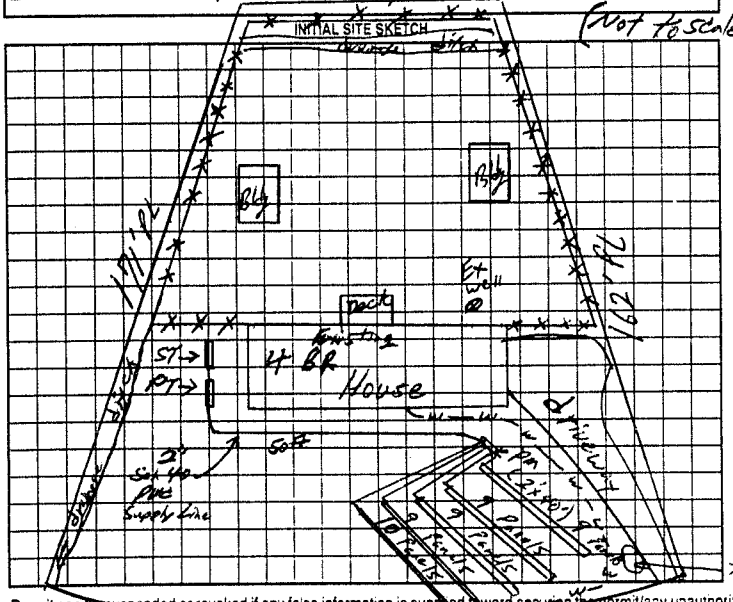

AS BUILT SKETCH 10/10/02 (WOJ)

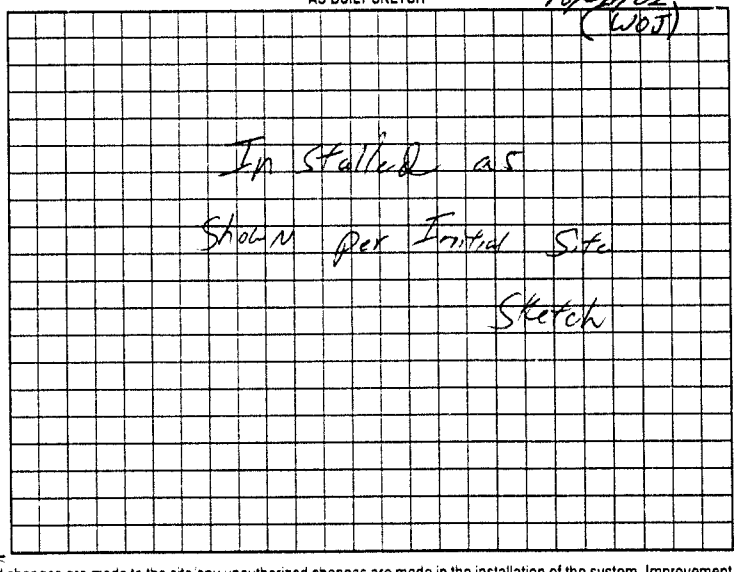

Permit can be suspended or revoked if any false information is supplied toward securing the permit, any unauthorized changes are made to the site, any unauthorized changes are made in the installation of the system. Improvement Permit with plat valid without expiration. Improvement Permit with site plan valid for sixty months. Authorization to Construct is valid for a period equal to that of Improvement Permit – not to exceed sixty months

Signed: Michael Joe Moore date 8/12/02 Installed by Sammy Reavis

Improvement Permit by: William O. Johnson date 8/14/02 Operation Permit by: William O. Johnson date 10/11/02

Authorization to Construct by: William O. Johnson date 8/14/02 Existing System Inspection by: — date —

HEALTH DEPT COPY WHITE OWNER COPY (FINAL) YELLOW OWNER COPY (INITIAL) PINK