IREDELL COUNTY HEALTH DEPARTMENT

Statesville Phone TR 3-7271 — Mooresville Phone NO 3-1271

PERMIT TO INSTALL SEPTIC TANK

Permit NO. _____ Permit Date 7 - 20 - 1961

Owner Carl Chambers Jr. Address Sherwood Forest

Installed By C Hoke Address R7 -


Location of Property 1st on rite in Sherwood forest.

Tank		Capacity		Length of Lines		Fixtures	
Block	( )	800	( )	150'	( )	No. of Baths	(1)
Precast	(✓)	900	( )	175'	( )	Dishwasher	( )
		1000	(✓)	200'	( )	Garbage Grdr.	( )
rock		1100	( )	225'	(✓)	Auto-Washer	(✓)
		1200	( )	250'	( )	Other	
		Other		Other			

NOTIFY HEALTH DEPARTMENT AT LEAST EIGHT HOURS BEFORE TANK IS TO BE INSPECTED.

Final Inspection 7 - 20 - 1961 Approved (✓) Disapproved ( )

Remarks line 5' wide - due to lay out of land

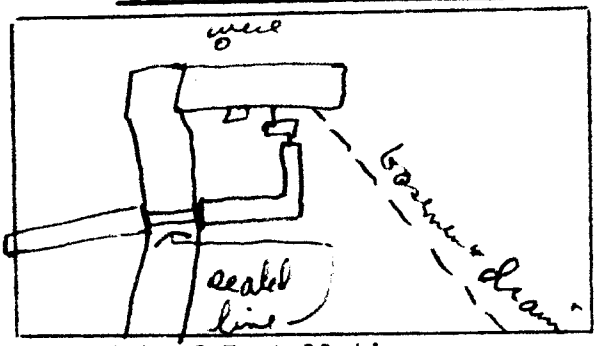

Sketch of Installation

Sanitarian