IREDELL COUNTY HEALTH DEPARTMENT

Statesville Phone TR 3-7271 — Mooresville Phone NO 3-1271

PERMIT TO INSTALL SEPTIC TANK

Permit NO. _____ John Johnson Builder Permit Date 11-2- 1961

Owner Richard DANNer. Address Sherwood Forest

Installed By CLYDE MOORE Address _____


Location of Property on left on main rd.

Tank	Capacity	Length of Lines	Fixtures
Block ( )	800 ( )	150' ( )	No. of Baths (2)
Precast (1)	900 ( )	175' ( )	Dishwasher ( )
	1000 (✓)	200' ( )	Garbage Grdr. ( )
Lock	1100 ( )	225' (✓)	Auto-Washer (✓)
	1200 ( )	250' ( )	Other _____
	Other _____	Other _____	

NOTIFY HEALTH DEPARTMENT AT LEAST EIGHT HOURS BEFORE TANK IS TO BE INSPECTED.

Final Inspection 11-2 1961 Approved (✓) Disapproved ( )

Remarks well 50'

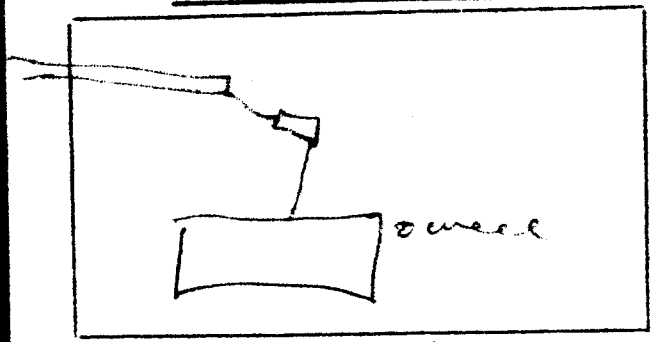

Sketch of Installation

Sanitarian