IREDELL COUNTY HEALTH DEPARTMENT

Statesville Phone TR 3-7271 Mooresville Phone NO 3-1271

PERMIT TO INSTALL SEPTIC TANK

Permit NO. Pudmont Bldg Co. Permit Date 3-28 19 60

Owner Carl Chambers Address Sherwood Forest

Installed By C Hoke Address R 7


Location of Property Rt 21 Statesville upon left Co. Rd 21 - in Sherwood Forest Dell

Tank		Capacity		Length of Lines		Fixtures	
Block	( )	800	( )	150'	( )	No. of Baths	( )
Precast	(✓)	900	(✓)	175'	( )	Dishwasher	( )
		1000	( )	200'	( )	Garbage Grdr.	( )
		1100	( )	225'	(✓)	Auto-Washer	( )
		1200	( )	250'	( )	Other	
		Other		Other			

NOTIFY HEALTH DEPARTMENT AT LEAST EIGHT HOURS BEFORE TANK IS TO BE INSPECTED.

Final Inspection 3 28 19 60 Approved ( ) Disapproved ( )

Remarks Well 75' - Satisfactory

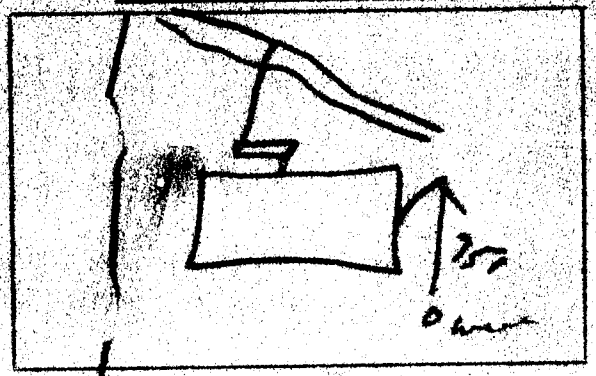

Sketch of Installation

R.A.J.

Sanitarian